

CODED

Jeff Davis
E 31
4-10-70

MISSISSIPPI
BOARD OF WATER COMMISSIONERS
416 North State Street
Jackson, Mississippi 39201

WATER WELL DRILLERS LOG

4-10-1970 PRENTISS BUTANE JEFF DAVIS
date well completed firm name county well located

LANDOWNER: VERA BRADY

description of formations encountered

from

to

PRENTISS, MISS

SAND & GRAVEL

0

180

(mailing address)

WELL LOCATION:

sec. 3 T 7 (N) R 19 E
1 miles W of PRENTISS
(distance) (direction) (nearest town)

WELL PURPOSE: HOME
(home, irrigation, municipal, industrial)

WELL COMPLETION DATA:

- (1) diameter (inches) 4 1/2"
- (2) total depth (feet) 180'
- (3) static water level (feet) 140' below above top of ground.
- (4) casing GAU, 175',
(material) (depth)
 if telescope see back.
(size)
- (5) screen 5', 175'
(length) (depth to top)
2", S.S.
(size) (material)
- (6) pump 3/4, 350
(HP) (yield gpm)
E
(type power)
- (7) electric log
(yes or no)

(organization running log)
- (8) how well bottom plugged B.W.V.

DRILLERS REMARKS:


APR 21 1970

MISS. BD. OF
WATER COMM.

CODED

If well telescopes please sketch and show depths.

GROUND LEVEL

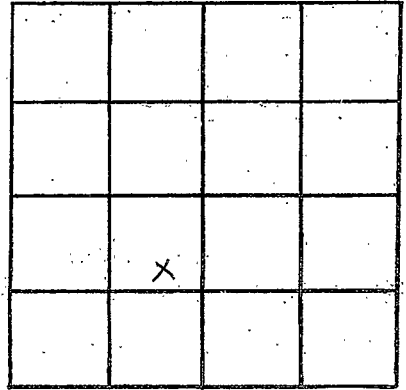

SECTION 3

Please indicate well location X.

ADDITIONAL INFORMATION

If more than one screen,
show locations of each on sketch.