

Jeff Davis
E 33
3-12-70

MISSISSIPPI
BOARD OF WATER COMMISSIONERS
416 North State Street
Jackson, Mississippi 39201

CODED

WATER WELL DRILLERS LOG

3-12-1970 PRENTISS BUTANE
date well completed firm name county well located
JEFF DAVIS

LANDOWNER:
JAMES WATTS
RT 1 SILVER CREEK
(mailing address)

description of formations encountered	from	to
CLAY-	0	16
GRAVEL	16	50
CHALK	50	150
CHALK + SAND	150	190
GRAVEL + SAND	190	216

WELL LOCATION:
sec. 24 T. 7N R. 20 E
S W
6 miles SE of PRENTISS
(distance) (direction) (nearest town)

WELL PURPOSE: HOME
(home, irrigation, municipal, industrial)

- WELL COMPLETION DATA:
- (1) diameter (inches) 2"
 - (2) total depth (feet) 216
 - (3) static water level (feet) 180 below top of ground.
 - (4) casing GALV 211 (material) (depth)
 - (size) if telescope see back.
 - (5) screen 5 211 (length) (depth to top)
 - 2" 5 S (size) (material)
 - (6) pump 3/4 350 (HP) (yield gpm)
 - E (type power)
 - (7) electric log (yes or no)
 - (organization running log)
 - (8) how well bottom plugged B.W.V.

CODED


APR 21 1970

MISS. BD. OF
WATER COMMISSIONERS

DRILLERS REMARKS:

If well telescopes please sketch and show depths.

GROUND LEVEL

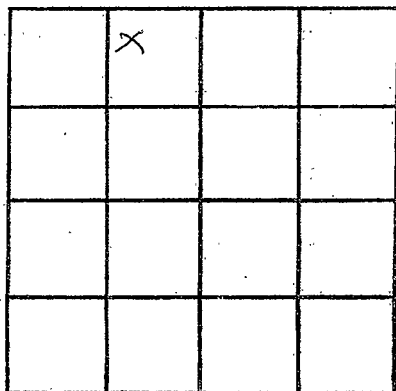

SECTION 24

Please indicate well location X.

ADDITIONAL INFORMATION

If more than one screen,
show locations of each on sketch.