

Jeff Davis  
E 34  
3-28-70

MISSISSIPPI  
BOARD OF WATER COMMISSIONERS  
416 North State Street  
Jackson, Mississippi 39201

CODED

WATER WELL DRILLERS LOG

3-28-1970 PRENTISS BUTANE JEFF DAVIS  
date well completed firm name county well located

LANDOWNER: HENRY LIRSEY	description of formations encountered	from	to
PRENTISS, MISS  (mailing address)	SAND	0	110
<b>WELL LOCATION:</b> sec 33 T 7 N R 19 E S W 7 miles S of PRENTISS (distance) (direction) (nearest town)			
<b>WELL PURPOSE:</b> HOME (home, irrigation, municipal, industrial)			
<b>WELL COMPLETION DATA:</b>			
(1) diameter (inches) 2			
(2) total depth (feet) 110			
(3) static water level (feet) 60 below top of ground.			
(4) casing GALV, 105 (material) (depth)			
_____ If telescope see back. (size)			
(5) screen 5, 105 (length) (depth to top)			
2" S.S. (size) (material)			
(6) pump 1, 600 (HP) (yield gpm)			
E (type power)			
(7) electric log _____ (yes or no)			
_____ (organization running log)			
(8) how well bottom plugged BWV			
<b>DRILLERS REMARKS:</b>			


CODED

APR 21 1970

MISS. BD. OF  
WATER COMM.

If well telescopes please sketch and show depths.

GROUND LEVEL

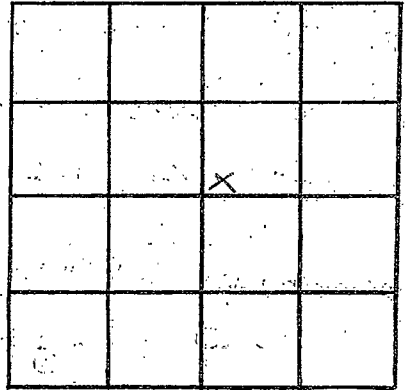

SECTION 33

Please indicate well location X.

ADDITIONAL INFORMATION

Lined area for providing additional information.

If more than one screen, show locations of each on sketch.