

JEFF DAVIS
E 36
8-17-70

MISSISSIPPI
BOARD OF WATER COMMISSIONERS
416 North State Street
Jackson, Mississippi 39201

CODED

WATER WELL DRILLERS LOG


8-17-1970 PRENTISS BUTANE JEFF DAVIS
date well completed firm name county well located

LANDOWNER:	description of formations encountered	from to
GERALD MCNEESE	SAND	0 60
PRENTISS (mailing address)		
WELL LOCATION: sec. 21 T. 7 N. S. R. 19 E. W. 5 miles SW of PRENTISS (distance) (direction) (nearest town)		
WELL PURPOSE: HOME (home, irrigation, municipal, industrial)		
WELL COMPLETION DATA:		
(1) diameter (inches) 2		
(2) total depth (feet) 60		
(3) static water level (feet) 20 ^{below} / _{above} top of ground.		
(4) casing PVC, 55 (material) (depth) (size) If telescope see back.		
(5) screen 5', 55' (length) (depth to top) 2" PVC (size) (material)		
(6) pump 3/4 (HP) (yield gpm) (type power)		
(7) electric log (yes or no) (organization running log)		
(8) how well bottom plugged B.W.V		
DRILLERS REMARKS: SET HIS PUMP	SEP 16 1970 MISS. RD. OF WATER COMM.	

CODED

If well telescopes please sketch and show depths.

GROUND LEVEL

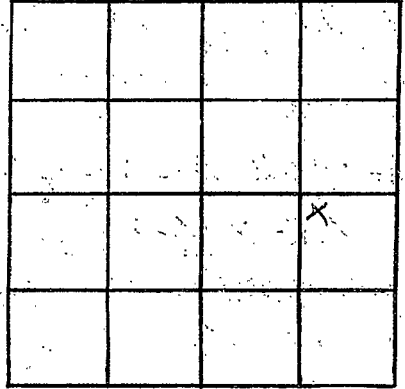

SECTION 21

Please indicate well location X.

ADDITIONAL INFORMATION

A series of horizontal lines for writing additional information, starting below the 'ADDITIONAL INFORMATION' header and extending down to the bottom of the page.

If more than one screen, show locations of each on sketch.