

Jeff Davis
E 38
7-15-70

MISSISSIPPI
BOARD OF WATER COMMISSIONERS
416 North State Street
Jackson, Mississippi 39201

CODED

WATER WELL DRILLERS LOG

7-15-70 date well completed 1970 PRENTISS BUTANE firm name JEFF DAVIS county well located

LANDOWNER:	description of formations encountered	from	to
JAMES MORPHIS	SAND	0	60
PRENTISS MISS (mailing address)			
WELL LOCATION: sec. 14 T. 7 N. R. 19 E. 2 miles S of PRENTISS (distance) (direction) (nearest town)			
WELL PURPOSE: HOME (home, irrigation, municipal, industrial)			
WELL COMPLETION DATA:			
(1) diameter (inches) 2			
(2) total depth (feet) 60			
(3) static water level (feet) 10 below top of ground.			
(4) casing PVC, 55' (material) (depth)			
_____ if telescope see back. (size)			
(5) screen 5' length, 55' depth to top			
2' PVC (size) (material)			
(6) pump 3/4 HP, 600 yield gpm			
E (type power)			
(7) electric log _____ (yes or no)			
_____ (organization running log)			
(8) how well bottom plugged B.W.V.			
DRILLERS REMARKS:			


CODED

JUL 21 1970

MISS. Bd. of
WATER COMMISSIONERS

If well telescopes please sketch and show depths.

GROUND LEVEL

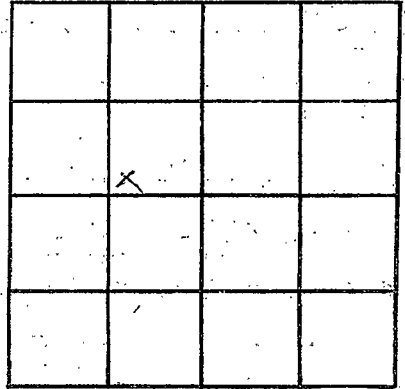

SECTION 14

Please indicate well location X.

ADDITIONAL INFORMATION

If more than one screen, show locations of each on sketch.