

JEFF DAVIS  
E 41  
9-12-70

MISSISSIPPI  
 BOARD OF WATER COMMISSIONERS  
 416 North State Street  
 Jackson, Mississippi 39201

**CODED**

WATER WELL DRILLERS LOG

9-12-1970 date well completed      PRENTISS BUTANE firm name      JEFF DAVIS county well located


LANDOWNER:	description of formations encountered	from	to
<u>WOODLEY HUDSON</u>	<u>CHALK</u>	<u>0</u>	<u>70</u>
<u>PRENTISS MISS</u> (mailing address)	<u>GRAVEL</u>	<u>70</u>	<u>90</u>
	<u>SAND</u>	<u>90</u>	<u>120</u>
<b>WELL LOCATION:</b>			
sec. <u>13</u> T. <u>7</u> (N) S. R. <u>19</u> (E) (W) <u>3</u> miles <u>E</u> of <u>PRENTISS</u> (distance) (direction) (nearest town)			
<b>WELL PURPOSE:</b> (home, irrigation, municipal, industrial)			
<b>WELL COMPLETION DATA:</b>			
(1) diameter (inches) <u>2"</u>			
(2) total depth (feet) <u>120</u>			
(3) static water level (feet) <u>70</u> (below/above top of ground)			
(4) casing <u>PVC</u> , <u>115'</u> (material) (depth) (size) If telescope see back.			
(5) screen <u>5'</u> , <u>115'</u> (length) (depth to top) <u>2'</u> , <u>PVC</u> (size) (material)			
(6) pump <u>1</u> <u>600</u> (HP) (yield gpm) <u>E</u> (type power)			
(7) electric log _____ (yes or no) _____ (organization running log)			
(8) how well bottom plugged <u>B.M.V.</u>			
<b>DRILLERS REMARKS:</b> _____			

**CODED**

DEC 28 1970

If well telescopes please sketch and show depths.

GROUND LEVEL

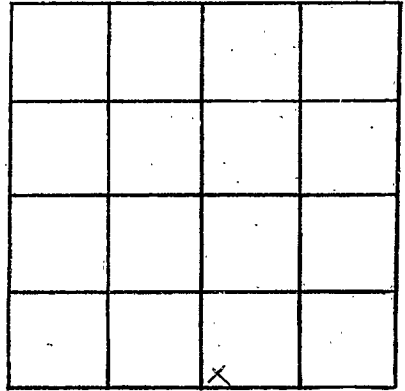

SECTION 13

Please indicate well location X.

ADDITIONAL INFORMATION

If more than one screen, show locations of each on sketch.