

JEFF DAVIS
E 42
12-21-70

MISSISSIPPI
BOARD OF WATER COMMISSIONERS
416 North State Street
Jackson, Mississippi 39201
WATER WELL DRILLERS LOG


CODED

12-21 1970 PRENTISS BUTANE GAS JEFF DAVIS
date well completed firm name county well located

LANDOWNER:	description of formations encountered	from	to
WIZZIE KELLY	CLAY	0	10
PRENTISS MISS (mailing address)	SAND	10	50
WELL LOCATION: SW NE sec. <u>11</u> T. <u>7</u> N. R. <u>19</u> E <u>2</u> miles <u>S</u> of <u>PRENTISS</u> (distance) (direction) (nearest town)			
WELL PURPOSE: (home, irrigation, municipal, industrial)			
WELL COMPLETION DATA:			
(1) diameter (inches) <u>2"</u>			
(2) total depth (feet) <u>50</u>			
(3) static water level (feet) <u>20</u> <u>below</u> top of ground. above			
(4) casing <u>PVC</u> , <u>4.5</u> , (material) (depth), <u> </u> if telescope see back. (size)	CODED		
(5) screen <u>5</u> , <u>4.5</u> (length) (depth to top)			
<u>2</u> , <u>PVC</u> (size) (material)			
(6) pump <u>1/2</u> , <u>550</u> (HP) (yield gpm)			
<u>F</u> (type power)			
(7) electric log <u> </u> (yes or no)			
<u> </u> (organization running log)			
(8) how well bottom plugged <u>BUV</u>			
DRILLERS REMARKS:	DEC 28 1970		

If well telescopes please sketch and show depths.

GROUND LEVEL

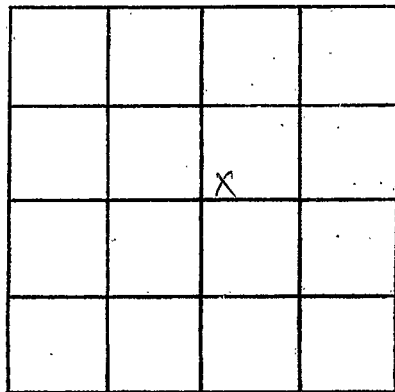

SECTION 11

Please indicate well location X.

ADDITIONAL INFORMATION

If more than one screen,
show locations of each on sketch.