

MISSISSIPPI  
 BOARD OF WATER COMMISSIONERS  
 416 North State Street  
 Jackson, Mississippi 39201

WATER WELL DRILLERS LOG **CODED**

Jeff Davis  
 E-47  
 7-71

July 1971 E.B. SHERARD JEFF DAVIS  
 date well completed firm name county well located

LANDOWNER:

ANGIA LENA BOURNE

Rt. 3 - PRENTISS  
 (mailing address)

WELL LOCATION:

sec 29 T 7 N R 19 E S W  
 6 miles SW of PRENTISS  
 (distance) (direction) (nearest town)

WELL PURPOSE:

home irrigation, municipal, industrial

WELL COMPLETION DATA:

- (1) diameter (inches) 2"
- (2) total depth (feet) 210
- (3) static water level (feet) 165 below top of ground.
- (4) casing 3" (material) PL (depth)  
3" (size) if telescope see back.
- (5) screen 6' (length) (depth to top)  
3" (size) (material) PL
- (6) pump 1/2 (HP) 8 (yield gpm)  
E (type power)
- (7) electric log (yes or no) (no)  
 (organization running log)
- (8) how well bottom plugged BWV

description of formations encountered

RED SANDY CLAY  
 + GRAVEL VERY  
 LOOSE MIXED  
 WITH SAND +  
 VERY QUICK  
 CHANGES TO STREAKS  
 OF CLAY 0 200  
 PURE PEA GRAVEL 200 210

from to

**CODED**


SEP 15 1971

DRILLERS REMARKS:

MISS. Bd. OF  
 WATER COMMISSIONERS

If well telescopes please sketch and show depths.

GROUND LEVEL

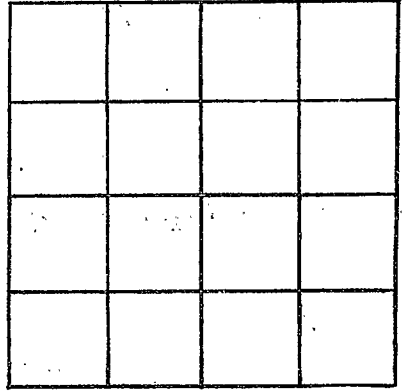

SECTION \_\_\_\_\_

Please indicate well location X.

ADDITIONAL INFORMATION

If more than one screen, show locations of each on sketch.