

JEFF DAVIS
E-49
8-19-71

MISSISSIPPI
BOARD OF WATER COMMISSIONERS
416 North State Street
Jackson, Mississippi 39201

WATER WELL DRILLERS LOG

CODED

8-19-1971
date well completed

71 PRENTISS BUTANE
firm name

JEFF DAVIS
county well located

LANDOWNER:	description of formations encountered	from	to
GARRAWAYS STORES			
PRENTISS MISS (mailing address)	SAND	10	80
WELL LOCATION:			
sec. 7 T. 20 ^N S. R. 19 E. W.			
W miles 3 of PRENTISS (distance) (direction) (nearest town)			
WELL PURPOSE: HOME (home, irrigation, municipal, industrial)			
WELL COMPLETION DATA:			
(1) diameter (inches) 2"			
(2) total depth (feet) 80			
(3) static water level (feet) 60 below top of ground.			
(4) casing PVC, 75' (material) (depth)			
(size) if telescope see back.			
(5) screen 5', 75' (length) (depth to top)			
2" PVC (size) (material)			
(6) pump 3/4 HP, 545 (HP) (yield gpm)			
ELECTRIC (type power)			
(7) electric log (yes or no)			
(organization running log)			
(8) how well bottom plugged B.W.V.			
DRILLERS REMARKS:			


CODED

SEP 22 1971

MISS. BD. OF
WATER COMMISSIONERS

If well telescopes please sketch and show depths.

GROUND LEVEL

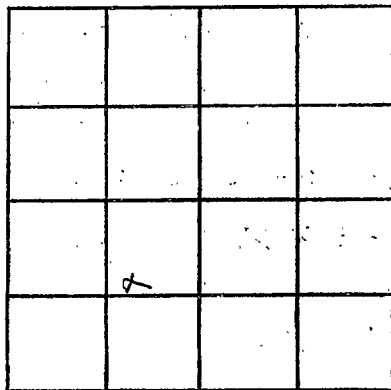

SECTION 7

Please indicate well location X.

ADDITIONAL INFORMATION

If more than one screen,
show locations of each on sketch.