

**JEFF DAVIS**  
**E 55**  
**10-71**

MISSISSIPPI  
 BOARD OF WATER COMMISSIONERS  
 416 North State Street  
 Jackson, Mississippi 39201

**CODED**

**WATER WELL DRILLERS LOG**

Oct. 19 71 E.B. SHEPARD JEFF DAVIS  
 date well completed firm name county well located

LANDOWNER:  
SOUTHERN BUILDERS  
PRENTISS, Miss.  
 (mailing address)

description of formations encountered	from	to
<u>EXTREMELY</u>		
<u>LOOSE SAND</u>		
<u>GRAVEL</u>	<u>0</u>	<u>158</u>
<u>LAST CIRCULATION</u>	<u>158</u>	<u>168</u>
<u>GRAVEL BOTTOM</u>		

WELL LOCATION:  
 sec 33 T 7 N R 19 E  
5 miles SW of PRENTISS  
 (distance) (direction) (nearest town)

WELL PURPOSE:  
 (home irrigation, municipal, industrial)

- WELL COMPLETION DATA:
- (1) diameter (inches) 3"
  - (2) total depth (feet) 168
  - (3) static water level (feet) 156 below above top of ground.
  - (4) casing PL. 162.  
 (material) (depth)  
3" If telescope see back.  
 (size)
  - (5) screen 6' (length) (depth to top)  
3" (size) PL. (material)
  - (6) pump NO pump (HP) ? (yield gpm)  
E (type power)
  - (7) electric log (yes or no) (no)  
 (organization running log)
  - (8) how well bottom plugged B.W.V.


**CODED**

FFB - 2 1971

DRILLERS REMARKS: MISS. BD. OF WATER COMMISSIONERS

If well telescopes please sketch and show depths.

GROUND LEVEL

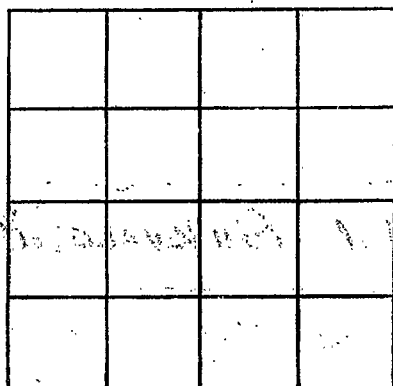

SECTION \_\_\_\_\_

Please indicate well location X.

ADDITIONAL INFORMATION

If more than one screen,  
show locations of each on sketch.