

JEFF DAVIS
E 5056
10-71

MISSISSIPPI
BOARD OF WATER COMMISSIONERS
416 North State Street
Jackson, Mississippi 39201

WATER WELL DRILLERS LOG

CODED

OCT. 1971 E.B. SHERRARD JEFF DAVIS
date well completed firm name county well located

LANDOWNER:

SOUTHERN BUILDERS

PRENTISS, Miss.
(mailing address)

description of formations encountered

LOOSE REDDISH
SAND + GRAVEL
NO CLAY

from

to

0 168

WELL LOCATION:

sec 33 T 7 N R 19 E
5 miles SW of PRENTISS
(distance) (direction) (nearest town)

WELL PURPOSE:

(Home Irrigation, municipal, industrial)

WELL COMPLETION DATA:

- (1) diameter (inches) 3"
- (2) total depth (feet) 168
- (3) static water level (feet) 152 below top of ground.
- (4) casing PL. 162' (material) (depth)
3" (size) if telescope see back.
- (5) screen 6' (length) (depth to top)
3" (size) PL. (material)
- (6) pump No Pump (HP) ? (yield gpm)
(type power)
- (7) electric log (yes or no)
- (organization running log)
- (8) how well bottom plugged B.W.V.

CODED


FFR - 2 1972

DRILLERS REMARKS:

MADE BY
AMERICAN MADE LOGS
PRINTED IN MISSISSIPPI

If well telescopes please sketch and show depths.

GROUND LEVEL

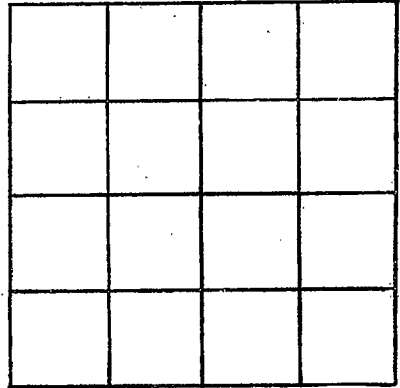

SECTION _____

Please indicate well location X.

ADDITIONAL INFORMATION

If more than one screen, show locations of each on sketch.