

JEFF DAVIS
E 60
8-4-72

MISSISSIPPI
 BOARD OF WATER COMMISSIONERS
 416 North State Street
 Jackson, Mississippi 39201

WATER WELL DRILLERS LOG


8-4-1972 PRENTISS JEFF DAVIS
 date well completed firm name county well located

LANDOWNER:	description of formations encountered	from	to
<u>ROY SPEIGHTS</u>		<u>SAND -</u>	<u>0</u>
<u>PRENTISS</u> (mailing address)			
WELL LOCATION:			
sec. <u>14</u> T <u>7</u> N S R <u>19</u> E <u>(W)</u>			
<u>2</u> miles <u>S</u> of <u>PRENTISS</u> (distance) (direction) (nearest town)			
WELL PURPOSE: <u>HOME</u> (home, irrigation, municipal, industrial)			
WELL COMPLETION DATA:			
(1) diameter (inches) <u>2"</u>			
(2) total depth (feet) <u>50</u>			
(3) static water level (feet) <u>10</u> <u>(below)</u> top of ground. <u>above</u>			
(4) casing <u>GALV</u> , <u>50</u> (material) (depth), <u> </u> if telescope see back. (size)			
(5) screen <u>5-</u> , <u>45</u> (length) (depth to top) <u>2</u> , <u>S.S.</u> (size) (material)			
(6) pump <u>HAND PUMP</u> (HP) (yield gpm) <u> </u> (type power)			
(7) electric log <u> </u> (yes or no) <u> </u> (organization running log)			
(8) how well bottom plugged <u>B.W.V.</u>			
DRILLERS REMARKS:			

NOV 17 1972
 MISSISSIPPI
 BOARD OF WATER COMMISSIONERS

If well telescopes please sketch and show depths.

GROUND LEVEL

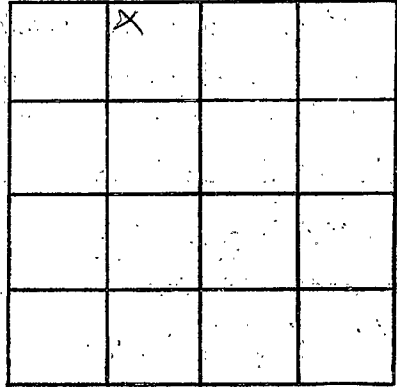

SECTION 14

Please indicate well location X.

ADDITIONAL INFORMATION

If more than one screen, show locations of each on sketch.