

JEFF DAVIS
E 61
3-73

MISSISSIPPI
 BOARD OF WATER COMMISSIONERS
 416 North State Street
 Jackson, Mississippi 39201

CODED

WATER WELL DRILLERS LOG

March 1973 E. B. Sheward Jeff Davis
 date well completed firm name county/well located

LANDOWNER:
Wilson Tractor Company
Prentiss, Miss.
 (mailing address)

description of formations encountered	from	to
RED CLAY	0	80'
CHANNEL		
CHANNEL WEAR	80	140'
LOESS		
RED BR & SAND	140	170'

WELL LOCATION:
 sec. 10-T-7 N R. 19 E
1 1/2 miles W Prentiss
 (distance) (direction) (nearest town)

WELL PURPOSE:
 (home) irrigation, municipal, industrial


- WELL COMPLETION DATA:**
- diameter (inches) 4"
 - total depth (feet) 178'
 - static water level (feet) 80' below top of ground. above
 - casing pl. 168'
 (material) (depth)
4" if telescope see back.
 (size)
 - screen 10' pl.
 (length) (depth to top)
4" pl.
 (size) (material)
 - pump 1 20
 (HP) (yield gpm)
E
 (type power)
 - electric log (yes or no)
 (organization running log)
 - how well bottom plugged BWV

CODED

DRILLERS REMARKS:

If well telescopes please sketch and show depths.

GROUND LEVEL

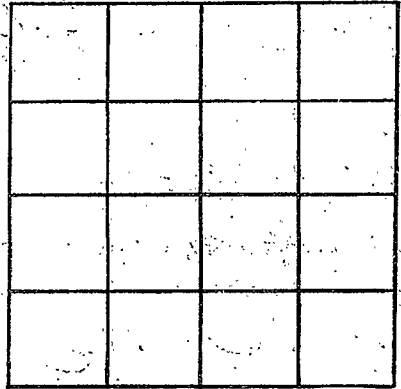

SECTION _____

Please indicate well location X.

ADDITIONAL INFORMATION

If more than one screen, show locations of each on sketch.