

Jeff Davis  
E 63  
3-2-74  
3/2/74

MISSISSIPPI  
BOARD OF WATER COMMISSIONERS  
416 North State Street  
Jackson, Mississippi 39201

CODED

WATER WELL DRILLERS LOG  
GRINER - GINN

Jeff Davis  
county well located

date well completed

firm name

LANDOWNER:  
Eddie Johnson  
Rt. 3 Bx 306, Prentiss  
(mailing address) Miss.

description of formations encountered	from	to
Top Soil	8	1
Clay	1	43
Clay + gravel	43	104
Clay + Chalk	104	140
Sand	140	183

WELL LOCATION:  
sec. 10 T. 7 N. R. 19 E.  
3 miles SW of Prentiss  
(distance) (direction) (nearest town)

WELL PURPOSE: Home  
(home, irrigation, municipal, industrial)

WELL COMPLETION DATA:

(1) diameter (inches) 2"

(2) total depth (feet) 183

(3) static water level (feet) 125 below top of ground.

(4) casing plastic, 173  
(material) (depth)  
2" (size) if telescope see back.

(5) screen 10', 173  
(length) (depth to top)  
2" plastic  
(size) (material)

(6) pump 2 (HP) 9' (yield gpm)  
elec. (type power)

(7) electric log NO (yes or no)  
NO (organization running log)

(8) how well bottom plugged B.W. Valve


CODED

DRILLERS REMARKS:

MISS. Bd. OF WATER LOGS

If well telescopes please sketch and show depths.

GROUND LEVEL

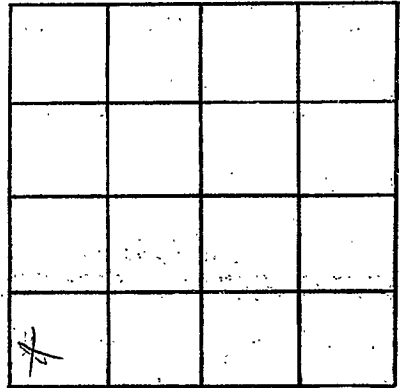

SECTION \_\_\_\_\_

Please indicate well location X.

ADDITIONAL INFORMATION

If more than one screen, show locations of each on sketch.