

JEFF Davis  
E 64  
4-19-74

MISSISSIPPI  
BOARD OF WATER COMMISSIONERS  
416 North State Street  
Jackson, Mississippi 39201

CODED

WATER WELL DRILLERS LOG  
GRINER - GINN

4-19 1974  
date well completed

firm name

Jefferson Davis  
county well located


LANDOWNER:	description of formations encountered	from	to
Willie Brown			
Prentiss (mailing address) Miss.	top Soil	0	+
	clay	1	44
	clay + gravel	44	108
	clay + chalk	108	148
	sand	148	185
<b>WELL LOCATION:</b> sec. 9-T 70 S R 19 E 4 miles SW of Prentiss (distance) (direction) (nearest town)			
<b>WELL PURPOSE:</b> Home (home, irrigation, municipal, industrial)			
<b>WELL COMPLETION DATA:</b>			
(1) diameter (inches) 2"			
(2) total depth (feet) 185'			
(3) static water level (feet) 110 below top of ground.			
(4) casing plastic (material), (depth) 2" (size) if telescope see back.			
(5) screen 10' (length), 175' (depth to top) 2" (size), plastic (material)			
(6) pump 1 1/2 (HP), 7 (yield gpm) elec (type power)			
(7) electric log No (yes or no) No (organization running log)			
(8) how well bottom plugged B.W. Valve			
<b>DRILLERS REMARKS:</b>			

CODED

FORM 2-4-1974

If well telescopes please sketch and show depths.

GROUND LEVEL

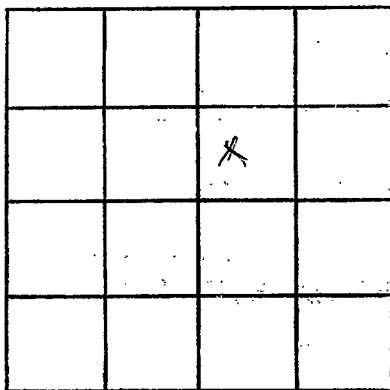

SECTION 9

Please indicate well location X.

ADDITIONAL INFORMATION

If more than one screen, show locations of each on sketch.