

JEFFERSON DAVIS

E-66

01/28/80

MISSISSIPPI BOARD OF WATER COMMISSIONERS  
416 North State Street  
Jackson, Mississippi 39201

CODED

WATER WELL DRILLERS LOG

Jefferson Davis

1-28-80 date well completed

Griner Drilling firm name

Jefferson Davis county well located

LANDOWNER:

Marion Corporation  
P.O. Box 51207  
Lafayette, La 70505  
(mailing address)

description of formations encountered

from

to

|                  |     |     |
|------------------|-----|-----|
| gravel sand      | 0   | 60  |
| clay, rock, sand | 60  | 183 |
| sand pea gravel  | 183 | 270 |
| clay             | 270 | 300 |

WELL LOCATION:

1600' N of 650' W of  
sec. 13 T. 7 N. of SE 1/4 of R. 20 E  
White sand field  
(distance) (direction) (nearest town)

No price

WELL PURPOSE: oil field supply  
(home, irrigation, municipal, industrial)

WELL COMPLETION DATA:

CODED

- (1) diameter (inches) 4"
- (2) total depth (feet) 300'
- (3) static water level (feet) 90' below top of ground.
- (4) casing steel 273' (material) (depth)  
4" (size) if telescope see back.
- (5) screen 42' 231' (length) (depth to top)  
4" (size) perforated (material)
- (6) pump (HP) 65 (yield gpm)  
AC (type power)
- (7) electric log (yes or no)

(organization running log)

- (8) how well bottom plugged orange peel

DRILLERS REMARKS:


DEPT. OF NATURAL RESOURCES  
BUREAU OF LAND & WATER RESOURCES

MAR 3 - 1980

RECEIVED

If well telescopes please sketch and show depths.

GROUND LEVEL

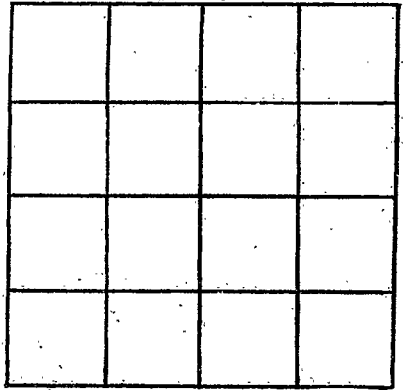

SECTION \_\_\_\_\_

Please indicate well location X.

ADDITIONAL INFORMATION

If more than one screen, show locations of each on sketch.