

JEFF. DAVIES

E-68
10/28/80

MISSISSIPPI
BOARD OF WATER COMMISSIONERS
416 North State Street
Jackson, Mississippi 39201

CODED

WATER WELL DRILLERS LOG

Spiner Drilling Service, Inc

Jefferson Davis

date well completed

firm name

county well located

LANDOWNER:

Marion Corporation
P.O. Box 3027
Mobile, Ala. 36652
(mailing address)

description of formations encountered

from

to

clay, sand, pebbles
gravel 0 21

WELL LOCATION:

750'S + 750'W of

sand - pea gravel 21 273

19-T-7

R-19 E NE 1/4

sand, pea gravel
rocks 273 280

Lucas - pretiss

0 miles (direction) (nearest town)

WELL PURPOSE:

oil field supply

WELL COMPLETION DATA:

(1) diameter (inches) 4"

(2) total depth (feet) 280'

(3) static water level (feet) 50' below top of ground

(4) casing steel 273' (material) (depth)

4" (size) if telescope see back.

(5) screen 42' 231' (length) (depth to top)

4" perforated (size) (material)

(6) pump - 65-70 (HP) (yield gpm)

ac (type power)

(7) electric log (yes or no)

(organization running log)

(8) how well bottom plugged range

peel

DRILLERS REMARKS:


DEPT. OF NATURAL RESOURCES
BUREAU OF LAND & WATER RESOURCES

NOV 25 1980

RECEIVED

If well telescopes please sketch and show depths.

GROUND LEVEL

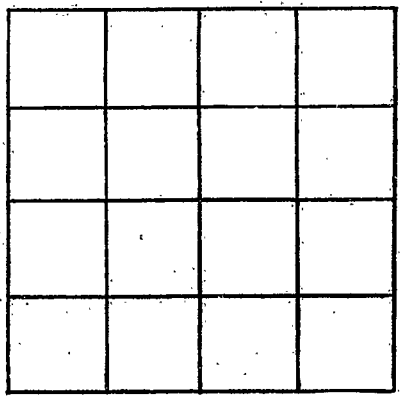

SECTION _____

Please indicate well location X.

ADDITIONAL INFORMATION

Lined area for additional information, consisting of approximately 25 horizontal lines.

If more than one screen, show locations of each on sketch.