

MISSISSIPPI DEPARTMENT OF NATURAL RESOURCES

Bureau of Land and Water Resources

Southport Mall

P.O. Box 10631

Jackson, Mississippi 39209

WATER WELL DRILLERS LOG

TOM GRIFFITH

PLUMBING & WELL SERVICE, INC.

320 MAYSON AVE.

Jeff Davis

county well located

Jefferson Davis
E 2000

May 17 1983
date well completed

LANDOWNER: Harvey Young

COLUMBIA, MS 39429

description of formations encountered

from to

Rt. 1

Top soil

0 1

Prentiss, MS

Red sand

1 20

(mailing address)

Gravel

20 70

WELL LOCATION:

Chalk

70 130

sec. 24 T. 7 N. S. R. 20 E. W.

Pea Gravel

130 185

miles of (distance) (direction) of (nearest town)

WELL PURPOSE: home
(home, irrigation, municipal, industrial)

WELL COMPLETION DATA:

- (1) diameter (inches) 2"
- (2) total depth (feet) 185'
- (3) static water level (feet) 140' (below above top of ground.)

(4) casing PUC, 165' (material) (depth)

N/A (size) if telescope see back.

(5) screen 20', 165' (length) (depth to top)

2" PUC (size) (material)

(6) pump 1/2 HP, 10 (yield gpm)

electric (type power)

(7) electric log none (yes or no)

(organization running log)

(8) how well bottom plugged b w u

DEPT. OF NATURAL RESOURCES
BUREAU OF LAND & WATER RESOURCES


JUL 25 1983

RECEIVED

DRILLERS REMARKS:

If well telescopes please sketch and show depths.

GROUND LEVEL

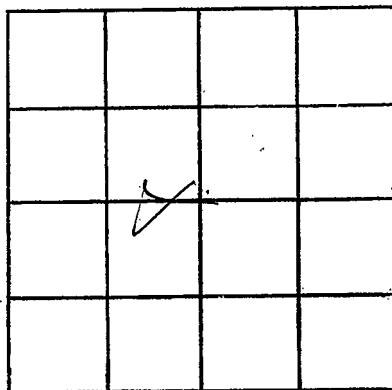

SECTION 24

Please indicate well location X.

ADDITIONAL INFORMATION

Lined area for additional information.

If more than one screen, show locations of each on sketch.