

Jeff Davis
 E 2001
 8-1-75

MISSISSIPPI
 BOARD OF WATER COMMISSIONERS
 416 North State Street
 Jackson, Mississippi 39201

13V

WATER WELL DRILLERS LOG

8-1 1975 Conover - BIRD Jeff Davis
 date well completed firm name county well located

LANDOWNER:
Rosie Young
LUCAS, Miss.
 (mailing address)


description of formations encountered	from	to
<u>Top Soil</u>	<u>0</u>	<u>1</u>
<u>Clay + chalk</u>	<u>1</u>	<u>69</u>
<u>Sand</u>	<u>69</u>	<u>100</u>

WELL LOCATION:
 sec. 5 T. 7 N. R. 19
1 1/2 miles W. of LUCAS
 (distance) (direction) (nearest town)

WELL PURPOSE: Home
 (home, irrigation, municipal, industrial)


- WELL COMPLETION DATA:
- (1) diameter (inches) 2"
 - (2) total depth (feet) 100
 - (3) static water level (feet) 65 ^{below} above top of ground.
 - (4) casing PVC 90
 (material) (depth)
2"
 (size) if telescope see back.
 - (5) screen 10' 90
 (length) (depth to top)
2" PVC
 (size) (material)
 - (6) pump 1 1/2
 (HP) (yield gpm)
elec.
 (type power)
 - (7) electric log NO
 (yes or no)
 (organization running log)
 - (8) how well bottom plugged B.W. Valve

DRILLERS REMARKS:

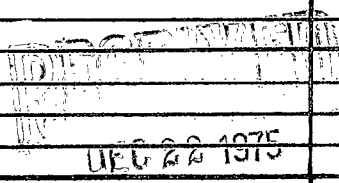

If well telescopes please sketch and show depths.

GROUND LEVEL

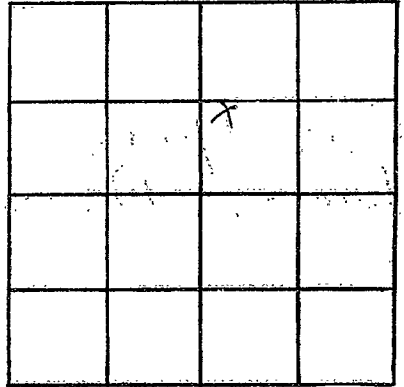

SECTION 

Please indicate well location X.

ADDITIONAL INFORMATION

If more than one screen,
show locations of each on sketch.