

Jeff Davis
 E 2007
 9-16-76

MISSISSIPPI
 BOARD OF WATER COMMISSIONER'S
 416 North State Street
 Jackson, Mississippi 39201

WATER WELL DRILLERS LOG

9-16 1976 Conner-Ginn Jeff Davis
 date well completed firm name county well located

LANDOWNER:
M. H. Herron
Rt 3, Prentiss
 (mailing address)

description of formations encountered	from	to
Top Soil	0	4
Clay	4	40
Chalk	40	150
gravel	150	250
Sands	250	325

WELL LOCATION:
 sec. 17 T 2 S R 20 E
3+ miles SW of Prentiss
 (distance) (direction) (nearest town)

WELL PURPOSE:
 (home) irrigation, municipal, industrial

- WELL COMPLETION DATA:
- (1) diameter (inches) 4"
 - (2) total depth (feet) 325
 - (3) static water level (feet) 150 ^{below}/_{above} top of ground.
 - (4) casing PVC, 305'
 (material) (depth)
4"
 (size) if telescope see back.
 - (5) screen 20', 305'
 (length) (depth to top)
4", PVC
 (size) (material)
 - (6) pump 3/4 (HP) _____ (yield gpm)
elec.
 (type power)
 - (7) electric log NO
 (yes or no)
 - _____
 (organization running log)
 - (8) how well bottom plugged B.W. Valve


RECEIVED
 MAR 23 1977

DRILLERS REMARKS:

MISS. BD. OF WATER COMMISSIONERS

If well telescopes please sketch and show depths.

GROUND LEVEL

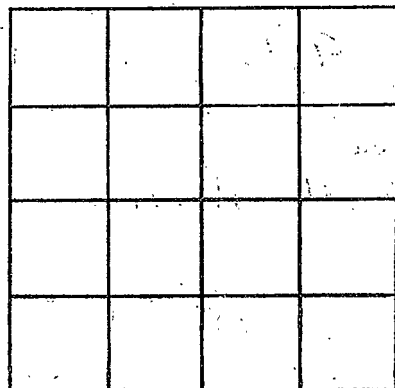

SECTION _____

Please indicate well location X.

ADDITIONAL INFORMATION

If more than one screen, show locations of each on sketch.