

Jefferson Davis
E 2003
5/5/77

MISSISSIPPI
BOARD OF WATER COMMISSIONERS
416 North State Street
Jackson, Mississippi 39201

WATER WELL DRILLERS LOG

May 5 19 77 Dunn Well Serv Jefferson Davis
date well completed firm name county well located

LANDOWNER:

Mr. Grayson Berry
Prentiss, Miss.
(mailing address)

description of formations encountered

from to

<u>Top Soil</u>	<u>0</u>	<u>1</u>
<u>clay</u>	<u>1</u>	<u>18</u>
<u>chert</u>	<u>18</u>	<u>89</u>
<u>Sand</u>	<u>89</u>	<u>120</u>

WELL LOCATION:

sec 28 T 7 N 19 R 18 E
7 miles SW of Prentiss
(distance) (direction) (nearest town)

WELL PURPOSE: Home
(home, irrigation, municipal, industrial)

WELL COMPLETION DATA:

- (1) diameter (inches) 4"
- (2) total depth (feet) 120 ft.
- (3) static water level (feet) 100 ft. below top of ground.
- (4) casing Plastic 110 ft.
(material) (depth)
4" (size) if telescope see back.
- (5) screen 10 ft. 110 ft.
(length) (depth to top)
4" Plastic
(size) (material)
- (6) pump 1 12
(HP) (yield gpm)
Elec
(type power)
- (7) electric log No
(yes or no)

(organization running log)

(8) how well bottom plugged B.W. Valve


DRILLERS REMARKS:

RECEIVED
MAY 10 1977
OCT 25 1977

MISS. BD. OF WATER COMMISSIONERS

If well telescopes please sketch and show depths.

GROUND LEVEL

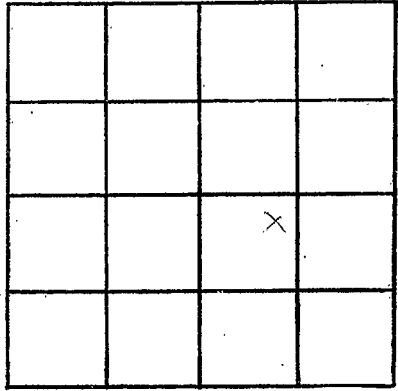

SECTION 26

Please indicate well location X.

ADDITIONAL INFORMATION

If more than one screen, show locations of each on sketch.