

Jeff Davis  
 # 2056  
 1-31-80

MISSISSIPPI  
 BOARD OF WATER COMMISSIONERS  
 416 North State Street  
 Jackson, Mississippi 39201

WATER WELL DRILLERS LOG

1-31  
 date well completed

1980 Nodding Well Co.  
 firm name

Jeff Davis  
 county well located

LANDOWNER: Cecil Pumble  
 Rt. 1 Box 58  
 Carson MS.  
 (mailing address)

description of formations  
 encountered

from to

sandy chalk 0 70  
 gravel, sand 70 96

WELL LOCATION:

sec. 25 T 7 N R 19 E  
 8 miles SW of CARSON  
 (distance) (direction) (nearest town)

WELL PURPOSE:

(home, irrigation, municipal, industrial)

WELL COMPLETION DATA:

- (1) diameter (inches) 2
- (2) total depth (feet) 96
- (3) static water level (feet) 50 below top of ground.
- (4) casing PVC 91 (material), (depth)  
 (size) if telescope see back.
- (5) screen 5 91 (length) (depth to top)  
 2 PVC (size) (material)
- (6) pump 1 8 (HP) (yield gpm)  
 elect (type power)
- (7) electric log (yes or no)

(organization running log)

(8) how well bottom plugged sand shale

DRILLERS REMARKS: good well


DEPT. OF NATURAL RESOURCES  
 BUREAU OF LAND & WATER RESOURCES

APR 14 1980

RECEIVED

If well telescopes please sketch and show depths.

GROUND LEVEL

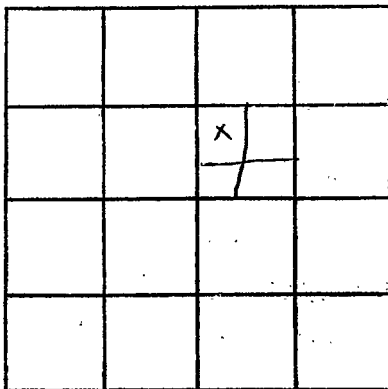

SECTION 25

Please indicate well location X.

ADDITIONAL INFORMATION

Lined area for additional information.

If more than one screen, show locations of each on sketch.