

Jefferson Davis
E 2008,
6/27/77

MISSISSIPPI
BOARD OF WATER COMMISSIONERS
416 North State Street
Jackson, Mississippi 39201

WATER WELL DRILLERS LOG

June 27 1977 Shaw Well Service Jefferson Davis
date well completed firm name county/well located

LANDOWNER:
Mr. Charles Clark
Prentiss, Miss.
(mailing address)

description of formations encountered	from	to
<u>Top Soil</u>	<u>0</u>	<u>1</u>
<u>Clay</u>	<u>1</u>	<u>16</u>
<u>Chalk</u>	<u>16</u>	<u>62</u>
<u>Sand</u>	<u>62</u>	<u>105</u>

WELL LOCATION:
sec. 24 T 7 N R 19 E
6 miles S.W of Prentiss
(distance) (direction) (nearest town)

WELL PURPOSE: Home
(home, irrigation, municipal, industrial)

- WELL COMPLETION DATA:
- (1) diameter (inches) 4"
 - (2) total depth (feet) 105 ft
 - (3) static water level (feet) 30 below top of ground.
 - (4) casing Plastic 95
(material) (depth)
4" if telescope see back.
(size)
 - (5) screen 10 ft 95
(length) (depth to top)
4" Plastic
(size) (material)
 - (6) pump 3/4 1 1/2
(HP) (yield gpm)
 - Elec
(type power)
 - (7) electric log no
(yes or no)

(organization running log)


(8) how well bottom plugged
B.W. Valve

DRILLERS REMARKS:

RECEIVED
OCT 25 1977
MISS. Bd. of Water Comm.

If well telescopes please sketch and show depths.

GROUND LEVEL

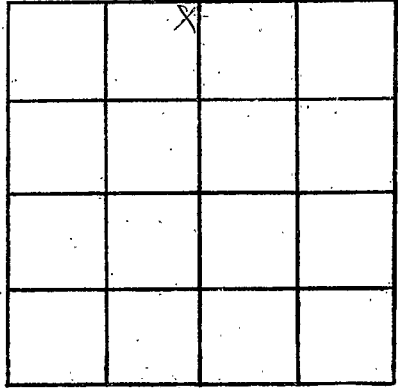

SECTION 24

Please indicate well location X.

ADDITIONAL INFORMATION

If more than one screen, show locations of each on sketch.