

Jeff Davis
E 2010

MISSISSIPPI
BOARD OF WATER COMMISSIONERS
416 North State Street
Jackson, Mississippi 39201

WATER WELL DRILLERS LOG

TOM GRIFFITH
TOM GRIFFITH & WELL SERVICE, INC.

Jan. 6 1987
date well completed

firm name

Jeff Davis County
county well located

LANDOWNER:

Herald Pope

Rt. 3, Box 33A
Prentiss, Miss. (mailing address)

WELL LOCATION:

sec. 25 T. 7 N. R. 19 E.
7 miles S of Prentiss
(distance) (direction) (nearest town)

WELL PURPOSE:

(home, irrigation, municipal, industrial)

WELL COMPLETION DATA:

- (1) diameter (inches) 4"
- (2) total depth (feet) 120'
- (3) static water level (feet) 50 below above top of ground.
- (4) casing PVC 100' (material) (depth)
4" (size) if telescope see back.
- (5) screen 100' (length) (depth to top)
4" (size) PVC (material)
- (6) pump 1/4 (HP) 10 (yield gpm)
Electric (type power)
- (7) electric log no (yes or no)
no (organization running log)
- (8) how well bottom plugged B.W.V.

description of formations encountered

from to

0-60 - (shale)

60-120 - Sand

DRILLERS REMARKS:


DEPT. OF NATURAL RESOURCES
BUREAU OF LAND & WATER RESOURCES

JUN - 9 1992

RECEIVED

If well telescopes please sketch and show depths.

GROUND LEVEL

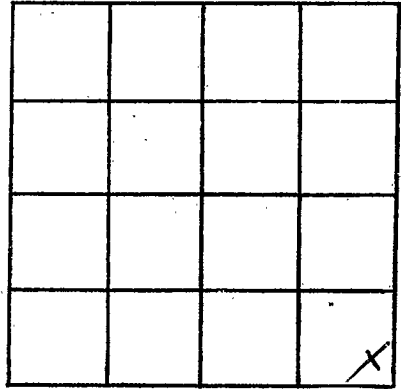

SECTION 25

Please indicate well location X.

ADDITIONAL INFORMATION

If more than one screen, show locations of each on sketch.