

MISSISSIPPI DEPARTMENT OF NATURAL RESOURCES

Bureau of Land and Water Resources

Southport Mall

P.O. Box 10631

Jackson, Mississippi 39209

WATER WELL DRILLERS LOG

TOM GRIFFITH

1983 PLUMBING & WELL SERVICE, INC.

Jeff Davis

Call Books
O/E E
2011

3/1 date well completed

1983

3271 N. GIBSON AVE.

county well located


LANDOWNER	Description of formations encountered	from	to
Sero-Butane Gas Co VA2	Topsoil	1'	5'
Prentiss, MS (mailing address)	Sand & Pea Gravel	5'	20'
WELL LOCATION: sec. 27 T. 70 N. R. 19 E. S W	Chalk	20'	30'
5 miles S of Prentiss (distance) (direction) (nearest town)	Sand & Pea Gravel	30'	110'
WELL PURPOSE: home (home, irrigation, municipal, industrial)			
WELL COMPLETION DATA:			
(1) diameter (inches) 4"			
(2) total depth (feet) 110'			
(3) static water level (feet) 25' below top of ground. above			
(4) casing PVC 90' (material) (depth)			
N/A if telescope see back. (size)			
(5) screen 20' 90' (length) (depth to top)			
4" PVC .010 (size) (material)			
(6) pump 1 12 (HP) (yield gpm)			
Elec. (type power)			
(7) electric log none (yes or no)			
N/A (organization running log)			
(8) how well bottom plugged BWV			

DRILLERS REMARKS:

DEPT. OF NATURAL RESOURCES
BUREAU OF LAND & WATER RESOURCES
MAR - 9 1983
RECEIVED

If well telescopes please sketch and show depths.

GROUND LEVEL

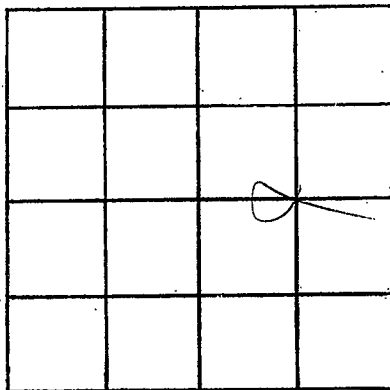

SECTION 27

Please indicate well location X.

ADDITIONAL INFORMATION

If more than one screen,
show locations of each on sketch.