

Jefferson Davis
E 2012

MISSISSIPPI DEPARTMENT OF NATURAL RESOURCES

Bureau of Land and Water Resources

Southport Mall

P.O. Box 10631

Jackson, Mississippi 39209

WATER WELL DRILLERS LOG

TOM GRIFFITH

3-16-1983 PLUMBING & WELL SERVICE, INC.

Jeff Davis

date well completed

320 W. MYGGLE AVE.

county well located

COLUMBIA, MS 39420

LANDOWNER: *E. D. Polk*

description of formations encountered

from

to

Rt-1

Top soil

0'

1'

Sand & Pea Gravel

1'

90'

Prentiss, MS

(mailing address)

WELL LOCATION: *NNW*

sec. *1* T. *9* N. R. *19* E.

2 miles *E* of *Prentiss*
(distance) (direction) (nearest town)

WELL PURPOSE: *Home*
(home, irrigation, municipal, industrial)

WELL COMPLETION DATA:

(1) diameter (inches) *2"*

(2) total depth (feet) *80'*

(3) static water level (feet) *15'* below above top of ground.

(4) casing *PVC*, *80'*
(material) (depth)

N/A if telescope see back.
(size)

(5) screen *10'*, *80'*
(length) (depth to top)

2", *PVC*
(size) (material)

(6) pump *?* *Custom*
(HP) (yield gpm)

(type power) *installed*

(7) electric log *No*
(yes or no)

(organization running log)

(8) how well bottom plugged *Ben*

DRILLERS REMARKS:


DEPT. OF NATURAL RESOURCES
BUREAU OF LAND & WATER RESOURCES

APR 20 1983

RECEIVED

If well telescopes please sketch and show depths.

GROUND LEVEL

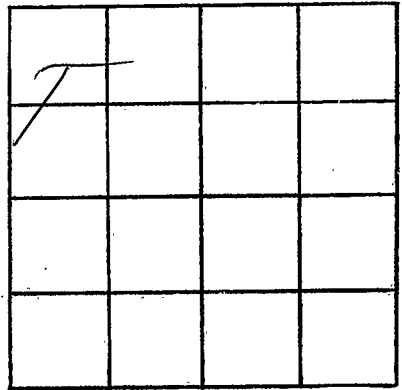

SECTION _____

Please indicate well location X.

ADDITIONAL INFORMATION

If more than one screen, show locations of each on sketch.