

MISSISSIPPI DEPARTMENT OF NATURAL RESOURCES

Bureau of Land and Water Resources

Southport Mall

P.O. Box 10631

Jackson, Mississippi 39209

WATER WELL DRILLERS LOG

TOM GRIFFITH

PLUMBING & WELL SERVICE, INC.

320 MATSON AVE.

COLUMBIA, MS 39429

county well located

Jefferson-Davis
Jefferson-Davis
E 2013

May 26 1983
 date well completed

Jefferson Davis

LANDOWNER: George Curley

description of formations encountered

from

to

Rt-2, Box 223 A

clay

0 20

Silver Creek, Ms 39663
 (mailing address)

sand - pea gravel

20 100

WELL LOCATION:

sec. 27 T. 7 N. R. 20 E.
5 miles S of Prentiss
 (distance) (direction) (nearest town)

WELL PURPOSE: home
 (home, irrigation, municipal, industrial)

WELL COMPLETION DATA:

- (1) diameter (inches) 4"
- (2) total depth (feet) 100'
- (3) static water level (feet) 20' below above top of ground.
- (4) casing PUC, 80'
 (material) (depth)
- N/A if telescope see back.
 (size)
- (5) screen 20', 80'
 (length) (depth to top)
- 4", PUC
 (size) (material)
- (6) pump none installed
 (HP) (yield gpm)
- by us.
 (type power)
- (7) electric log _____
 (yes or no)

(organization running log)

(8) how well bottom plugged buw

DRILLERS REMARKS:


DEPT. OF NATURAL RESOURCES
 BUREAU OF LAND & WATER RESOURCES

JUL 25 1983

RECEIVED

If well telescopes please sketch and show depths.

GROUND LEVEL

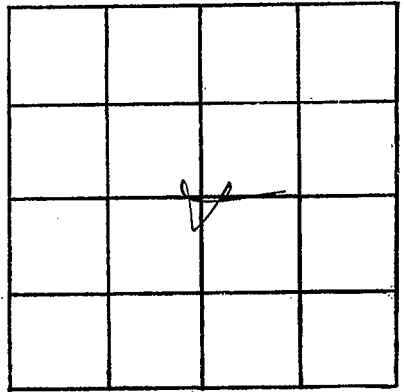

SECTION 27

Please indicate well location X.

ADDITIONAL INFORMATION

If more than one screen,
show locations of each on sketch.