

MISSISSIPPI DEPARTMENT OF NATURAL RESOURCES

Bureau of Land and Water Resources

Southport Mall

P.O. Box 10631

Jackson, Mississippi 39209

WATER WELL DRILLERS LOG

Jefferson Davis
E 2014

6-20 1983
date well completed

B Hollinger
firm name

Jeff Davis
county well located

LANDOWNER: <u>Bernard E. Jones</u>	description of formations encountered	from	to
RT1			
<u>Silver Creek, ms</u> (mailing address)	Chalk, Clay	0	25
	sand, Clay, Chalk	25	60
	Chalk, Clay	60	95
	GRAVELS	95	105
	per gravel	105	127
WELL LOCATION: sec. <u>20</u> T. <u>7</u> N. R. <u>19</u> E. <u>W</u> <u>5</u> miles <u>SW</u> of <u>Prentiss</u> (distance) (direction) (nearest town)			
WELL PURPOSE: (home, irrigation, municipal, industrial)			
WELL COMPLETION DATA:			
(1) diameter (inches) <u>2"</u>			
(2) total depth (feet) <u>127</u>			
(3) static water level (feet) <u>25</u> <u>below</u> top of ground.			
(4) casing <u>PVC</u> , <u>117</u> , (material) (depth)			
(size) if telescope see back.			
(5) screen <u>10</u> , <u>117</u> (length) (depth to top)			
<u>2"</u> , <u>PVC</u> (size) (material)			
(6) pump <u>1</u> , <u>15</u> (HP) (yield gpm)			
<u>elect</u> (type power)			
(7) electric log _____ (yes or no)			
(organization running log)			
(8) how well bottom plugged <u>SAND</u> <u>SHARK</u>			
DRILLERS REMARKS: <u>Good well</u>			


DEPT. OF NATURAL RESOURCES
BUREAU OF LAND & WATER RESOURCES

SEP 27 1983

RECEIVED

If well telescopes please sketch and show depths.

GROUND LEVEL

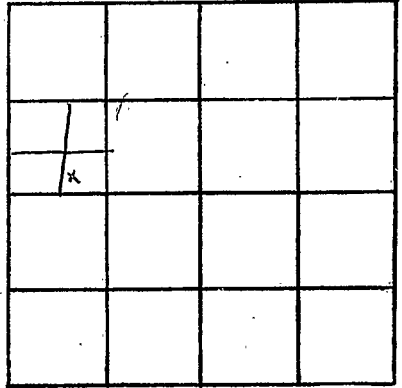

SECTION 20

Please indicate well location X.

ADDITIONAL INFORMATION

If more than one screen, show locations of each on sketch.