

MISSISSIPPI DEPARTMENT OF NATURAL RESOURCES
 Bureau of Land and Water Resources
 Southport Mall
 P.O. Box 10631
 Jackson, Mississippi 39209
WATER WELL DRILLERS LOG


Jeff Davis
E 2015

9-28 1984 Hollinger Jeff Davis
 date well completed firm name county well located

LANDOWNER: <u>Charles Lucas</u> <u>RT-3</u>	description of formations encountered	from	to
<u>Prentiss, MS</u> (mailing address)	<u>Sand, & gravel</u>	<u>0</u>	<u>150</u>
WELL LOCATION: <u>NW NE</u> sec. <u>12</u> T. <u>7N</u> S. R. <u>20</u> E. <u>W</u> <u>At</u> miles of <u>Lucas</u> (distance) (direction) (nearest town)			
WELL PURPOSE: (home, irrigation, municipal, industrial)			
WELL COMPLETION DATA:			
(1) diameter (inches) <u>2</u>			
(2) total depth (feet) <u>185</u>			
(3) static water level (feet) <u>60</u> ^{below} _{above} top of ground.			
(4) casing <u>PVC</u> , <u>175</u> (material) (depth)			
_____ if telescope see back. (size)			
(5) screen <u>10</u> , <u>175</u> (length) (depth to top)			
_____ <u>2</u> , <u>PVC</u> (size) (material)			
(6) pump <u>1 1/2</u> , <u>9</u> (HP) (yield gpm)			
_____ <u>elect</u> (type power)			
(7) electric log _____ (yes or no) _____ (organization running log)	DEPT. OF NATURAL RESOURCES BUREAU OF LAND & WATER RESOURCES		
(8) how well bottom plugged <u>Sand</u> <u>SHARK</u>	NOV 20 1984		
DRILLERS REMARKS: <u>Good well</u>	RECEIVED		

If well telescopes please sketch and show depths.

GROUND LEVEL

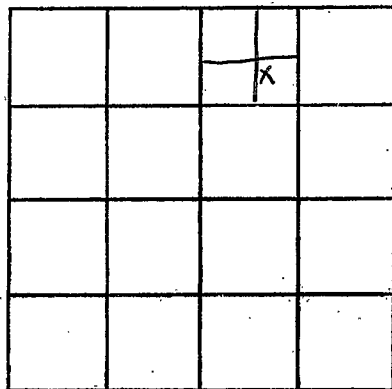

SECTION 12

Please indicate well location X.

ADDITIONAL INFORMATION

If more than one screen,
show locations of each on sketch.