

*Jeff Davis*  
 E 2016

MISSISSIPPI DEPARTMENT OF NATURAL RESOURCES  
 Bureau of Land and Water Resources  
 Southport Mall  
 P.O. Box 10631  
 Jackson, Mississippi 39209  
**WATER WELL DRILLERS LOG**

10-29 1984 Hollinsie Jeff Davis  
 date well completed firm name county well located

LANDOWNER: Debra Barnes  
Prentiss  
 (mailing address)

description of formations encountered	from	to
Sand, gravel	0	100
gravel, sand, clay	100	150
fine gravel	150	180

WELL LOCATION:  
 sec. 21 T. 7 (N) R. 19 (W)  
AT miles of Progress  
 (distance) (direction) (nearest town)

WELL PURPOSE:  
 (home, irrigation, municipal, industrial)

- WELL COMPLETION DATA:
- (1) diameter (inches) 2"
  - (2) total depth (feet) 180
  - (3) static water level (feet) 100 below above top of ground.
  - (4) casing pvc 170  
 (material) (depth)  
 (size) if telescope see back.
  - (5) screen 10 170  
 (length) (depth to top)  
2 pvc  
 (size) (material)
  - (6) pump 1 1/2 8  
 (HP) (yield gpm)  
elect  
 (type power)
  - (7) electric log \_\_\_\_\_  
 (organization running log)
  - (8) how well bottom plugged sand  
SHAKIC

DRILLERS REMARKS:


DEPT. OF NATURAL RESOURCES  
 BUREAU OF LAND & WATER RESOURCES

NOV 20 1984

RECEIVED

If well telescopes please sketch and show depths.

GROUND LEVEL

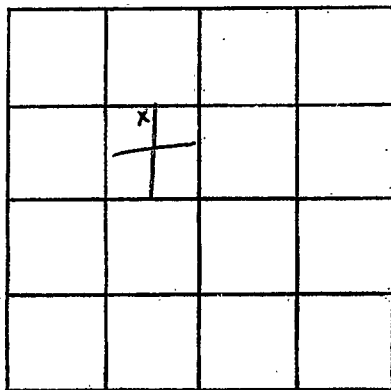

SECTION 21

Please indicate well location X.

ADDITIONAL INFORMATION

If more than one screen, show locations of each on sketch.