

JEFF DAVIS
E 247

MISSISSIPPI
BOARD OF WATER COMMISSIONERS
416 North State Street
Jackson, Mississippi 39201

WATER WELL DRILLERS LOG

4-15-82
date well completed

firm name

Jeff Davis
county well located

LANDOWNER:
James Strickland
Silver Creek Miss
(mailing address)

description of formations encountered from to

WELL LOCATION:

sec. T N R E
S
Silver Creek
miles of (distance) (direction) (nearest town)

WELL PURPOSE:

(home, irrigation, municipal, industrial)

WELL COMPLETION DATA:

- (1) diameter (inches) 2.11
- (2) total depth (feet) 180'
- (3) static water level (feet) 110' below top of ground.
- (4) casing plastic, 160' (material) (depth)
- (size) If telescope see back.
- (5) screen 20' (length) (depth to top)
- (size) (material)
- (6) pump (HP) (yield gpm)
- (type power)
- (7) electric log (yes or no)
- (organization running log)
- (8) how well bottom plugged

DRILLERS REMARKS:


DEPT. OF NATURAL RESOURCES
BUREAU OF LAND & WATER RESOURCES

JUN 25 1982

RECEIVED

If well telescopes please
sketch and show depths.

GROUND LEVEL

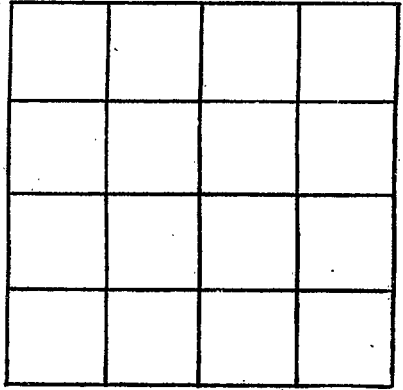

SECTION _____

Please indicate well location X.

ADDITIONAL INFORMATION

If more than one screen,
show locations of each on sketch.