


JEFF DAVIS MISSISSIPPI BOARD OF WATER COMMISSIONERS
F5 **CODED** WATER WELL DRILLERS LOG
 Date: 10-15-62 Driller: E. B. SHERRARD County: JEFF DAVIS
 (Name)

(1) Owner of Land:	Description & Color of Materials Sand, Clay, Red Clay, Shell, etc.	Thick- ness Feet	Depth Feet
<u>KYLE PARKMAN</u> (Name)	<u>RED CLAY</u>		<u>10</u>
<u>PRENTISS, MISS.</u> (Address)	"		<u>20</u>
(2) Location: <u>2 7/8</u> Sec. <u>2</u> T. <u>7</u> R. <u>8</u> <u>8</u> miles <u>E.</u> of <u>PRENTISS</u> (distance) (direction) (Nearest Town)	<u>SANDY RED CLAY</u>		<u>30</u>
(3) Topography: <input checked="" type="checkbox"/> (Hilly) <input type="checkbox"/> (Flat) <input type="checkbox"/> (Level)	"		<u>40</u>
(4) Purpose of Well: <input checked="" type="checkbox"/> (Domestic Irrigation) <input type="checkbox"/> (Municipal) <input type="checkbox"/> (Industrial) <input type="checkbox"/> (Other)	<u>GRAY CLAY</u>		<u>50</u>
Information upon completion of well:	"		<u>60</u>
(1) Diameter: <u>2</u> inches	"		<u>70</u>
(2) Total Depth: <u>190</u> feet	<u>SANDY CLAY</u>		<u>80</u>
(3) Water Level: <u>120</u> feet below top of ground	"		<u>90</u>
(4) Cased to <u>190</u> Size <u>2"</u>	<u>SAND</u>		<u>100</u>
(5) Screen: Size <u>2"</u> Length <u>5'</u>	"		<u>110</u>
(6) Were any formations sealed against pollution? yes <input type="checkbox"/> no <input checked="" type="checkbox"/>	<u>PEA GRAVEL</u>		<u>120</u>
If YES depth of formation	"		<u>130</u>
Why	"		<u>140</u>
Drillers Remarks	"		<u>150</u>
	"		<u>160</u>
	"		<u>170</u>
	"		<u>180</u>
	"		<u>190</u>

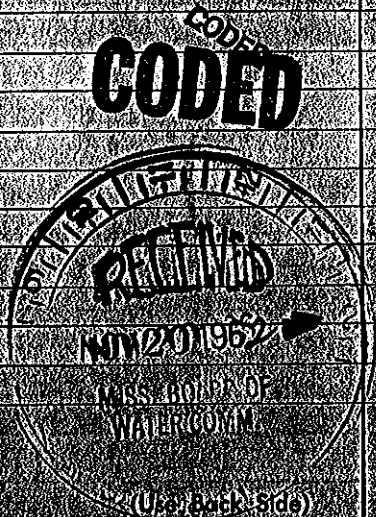

Mail this copy to Board of Water Commissioners 429 Miss. St. Jackson, Miss.