

Jeff DAVIS
F6
4-12-63

MISSISSIPPI BOARD OF WATER COMMISSIONERS

WATER WELL DRILLERS LOG **CODED**

Date: 4-12-1963, Driller: F.B. SHERRARD County: DAVIS
(Name)


(1) Owner of Land: FRANK KING
(Name)
Rt 1 - PRENTISS, MISS.
(Address)
(2) Location: 1/4, 1/4, Sec. 17 T. 7 R. 8,
3 miles W of CARSON,
(distance) (direction) (Nearest Town)
MISS.
(3) Topography: _____
(Hilly) (Flat) (Level)
(4) Purpose of Well: Domestic
(Domestic Irrigation
Municipal, Industrial, Other)

Description & Color of Materials Sand, Clay, Red Clay, Shell, etc.	Thick- ness Feet	Dep Feet
<u>RED CLAY</u>		<u>20</u>
<u>GRAVEL</u>		<u>40</u>
<u>SAND & CLAY</u>		<u>62</u>
		<u>80</u>
<u>GRAVEL</u>		<u>90</u>

CODED

Information upon completion of well:

(1) Diameter 2 inches.
(2) Total Depth 91 feet.
(3) Water Level 30 feet below top of ground.
(4) Cased to _____, Size _____
(5) Screen: Size 2", Length 5'
(6) Were any formations sealed against pollution?
_____ yes, _____ no.

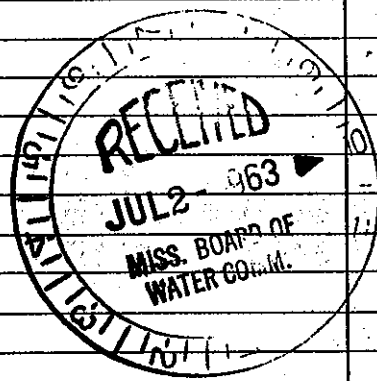

If YES depth of formation _____
Why _____
Drillers Remarks: _____

(Use Back Side)

Well No.

Mail this copy to Board of Water Commissioners 429 Miss. St. Jackson, Miss