

JEFF DAVIS

MISSISSIPPI BOARD OF WATER COMMISSIONERS

F 7

CODED WATER WELL DRILLERS LOG

5-18-66

Date: 5-18, 1966, Driller: E. B. SHEPPARD County: JEFF DAVIS

(1) Owner of Land:	Description & Color of Materials Sand, Clay, Red Clay, Shell, etc.	Thick- ness Feet	Dep Feet
GEORGE BUTLER (Name)	RED SANDY	30"	
CARSON RT. (Address)	CLAY	"	
T. 7. N.	SANDY	60"	
Location: 1/4, 1/4, Sec. 31, T. R.	SAND & GRAVEL	76"	
4 miles S. of PRENTISS (distance) (direction) (Nearest Town)			
(3) Topography: <input checked="" type="checkbox"/> (Hilly) <input type="checkbox"/> (Flat) <input type="checkbox"/> (Level)			
(4) Purpose of Well: DOMESTIC (Domestic Irrigation Municipal, Industrial, Other)			

Information upon completion of well:

(1) Diameter 2" inches.

(2) Total Depth 76 feet.

(3) Water Level 56 feet below top of ground.

(4) Cased to 76, Size 2"

(5) Screen: Size 2", Length 3"


(6) Were any formations sealed against pollution?  
 \_\_\_\_\_ yes,  no.

CODED

If YES depth of formation \_\_\_\_\_

Why \_\_\_\_\_

Drillers Remarks: \_\_\_\_\_

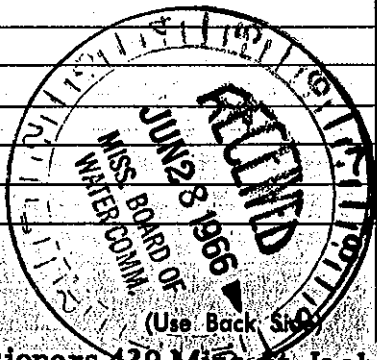

Well No.

Mail this copy to Board of Water Commissioners 429 Miss. St. Jackson, Miss.