

MISSISSIPPI DEPARTMENT OF NATURAL RESOURCES

Bureau of Land and Water Resources

Southport Mall

P.O. Box 10631

Jackson, Mississippi 39209

CODED

WATER WELL DRILLERS LOG

Griner Drilling Service, Inc.

Jefferson Davis

Jefferson Davis  
F 44  
4-7-81

date well completed

firm name

county well located

LANDOWNER:  
Amoco Production  
P.O. Box 519 21  
Lafayette, La 70505  
(mailing address)

description of formations encountered

from to

streaked

0 105

sand & gravel

105 378


WELL LOCATION: 1500' S of 1500' E of

Vol. 13 T 7 R 18  
Williams Carson Field  
Unit 13-6 (distance) (direction) (nearest town)

WELL PURPOSE: oil field supply  
(home, irrigation, municipal, industrial)

WELL COMPLETION DATA:

- (1) diameter (inches) 3"
- (2) total depth (feet) 378'
- (3) static water level (feet) 80' below top of ground.
- (4) casing steel 378' (material) (depth)  
3" (size) If telescope see back.
- (5) screen 42' 336' (length) (depth to top)  
3" perforated (size) (material)
- (6) pump AC 75 (HP) (yield gpm)  
(type power)
- (7) electric log (yes or no)  
(organization running log)
- (8) how well bottom plugged orange peel

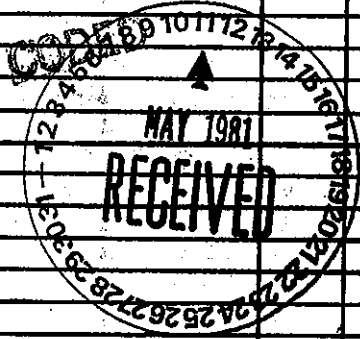

DRILLERS REMARKS: