County: <u>Jefferson Davis</u> Permit #: Driller: <u>James M. Wells</u> Date drilling completed: <u>8-3-15</u> Mississippi D Office	TE WELL REPORT Part 1 Driller's Log epartment of Environmental Quality of Land and Water Resources P.O. Box 2309 Jackson, MS 39225-2309 (601)961-5210 (601)360-0535 (fax)	For Office Use Only: Well #: 49 Aquifer:		
	State Law requires that this report be prepared by the license holder responsible for the work and filed with the Department at the above address within 30 days of completion of drilling of the well or borehole.			
Well Owner Information (Landowner if borehole is not for a water well Owner Name: Buddy Bullocic Mailing Address: 	3 3 3 79 Well or Bore Latitude: <u>31°33.828</u> Lor Method of Lat/Long (<i>check one</i> USGS quad, Hand-held G NN 1/4 NW 1/4, Sec 2	hole Location 89 4/01 ngitude: 089 41.018): Conventional Survey,		
	all / Developing Dete			
Date drilling started: <u>§-3.15</u> Date drilling comp Location of the source of any surface water used for Method of dosing and volume of Chlorine used in dri Logs run (<i>circle all applicable</i>): <u>volog run</u> Electric Name of organization running log(s): Purpose of borehole (<i>circle one</i>): Water Well Seismic Survey	Purpose of borehole (circle one): Water Well Geotechnical/Geological Investigation Ground Source Heat Pump			
Purpose of Well (circle all applicable): Home Indu Other (<i>describe</i>):				
Method of measurement (<i>circle one</i>): Steel tape El Well depth: <u>185</u> Well grouted to a depth of: <u></u> Casing length: <u>1165</u> feet Casing diameter Screen length: <u>20</u> feet Screen diameter	below] land surface Date measured ectric tape Air line Other (<i>describe</i>) feet Type of grout (<i>circle one</i>) er:inches Type of a ter:inches Type of a ter:	Neat Cemen Bentonite Mix casing: screen:		
	Top of lap pipe or reduction in casing: feet If telescoped or more than one screen, describe on next page BY: OIWP			

· •

Form: OLWR-SWR-1A (4/13)


county: Jefferson Davis	
-------------------------	--

Permit #:

The sketch below only required for water wells

For Office Use Only: Well #: 99

Description of formations encountered must be provided for all wells and boreholes, unless specifically exempted by regulations

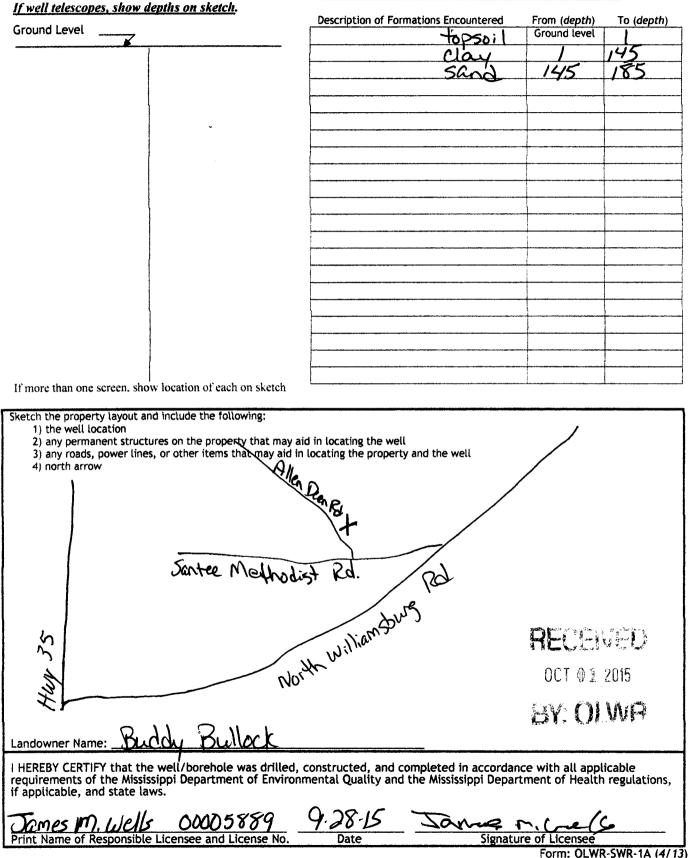

STATE W	ELL REPORT		
County: Sefferson Davis Permit #: Driller: Dames M. Wells Date completed: 8.3-15 <u>Copy information from block on Part 1</u> This part of the report must be completed by a licensed water of the report must be attached and both parts filed with the L Well Owner Information Owner Name: Buddy Bulock Mailing Address:	Part 2 r's Completion Report ment of Environmental Quality and Water Resources .0. Box 2309 bon, MS 39225-2309 501)961-5210) 360-0535 (fax) well contractor or a licensed purport pepartment at the above address well Well L Latitude: <u>31°33, 528</u> Lor Method of Lat/Long (check one	ocation ngitude: 089°41,018, c): Conventional Survey,	
170 Allen Deen Kd. Bassfield MS 3942 City Telephone No. (CODI) 447-5415	USGS quad, Hand-held G ¼¼, Sec ¼¼, Sec (Distance) (Direction)	23 T 7N R/TW	
Pump Type (circle one)			
Submersible Turbine Air Lift Centrifugal Flowing Well Jet Piston Rotary Other (describe):			
Pump Test Data for Non Flowing Well Date Well Tested: 8-3-15 Duration of Pump Test (minimum 4 hours): 4 hours): Static Water Level (A): 100 Feet Below Land Surface Pumping Water Level (B): 150 Feet Below Land Surface Drawdown [(B) - (A)]: 100 Feet Below Land Surface Test Pumping Rate: 17 Gallons Per Minute Method of measurement (circle one): Steel tape) Electric tape Air line Other (describe):			
Pump Test Da	ata for Flowing Well		
Measured shut in head:feet. Well yieldedGPM with a drawdown of	feet after	_hours of pumping	
	Installation		
Meter Manufacturer: Meter Serial Number:			
Meter Model Number/Name:			
Totalizer Register Unit and Multiplier Factor (AF x .001, ga Installation Date: Meter installed by:	al x 1000, etc):	RECEIVED	
Is This Meter (circle one): New Repaired Replacem	nent	OCT 01 2015	
Important: By submitting the above information you are certifying that this meter was installed to manufacturer standards. For agricultural wells, a list of approved meters is on the MDEQ website.			
I HEREBY CERTIFY that the above statements are true to the best of my knowledge.			
James M. Wells 00005889	9-28:15 Jam		
Print Name of Pump Installer and License No. (if applicable	e) Date Sign	ature of Pump Installer Form: OLWR-SWR-1B (4/	

×

.

.

...

³⁾