

WATER WELL DRILLERS LOG


4-20-63 CODED  
 Date: 4-20, 1963, Driller: E.B. SHERARD County: JEFF. DAVIS

(1) Owner of Land: Mrs. Lillian Hilton  
 (Name)  
 OAKVALE, Miss.  
 (Address)  
 (2) Location: 1/4, 1/4, Sec. 31 T. R.  
 IN TOWN, of OAKVALE  
 (distance) (direction) (Nearest Town)  
 (3) Topography:  (Hilly) (Flat) (Level)  
 (4) Purpose of Well: Domestic  
 (Domestic Irrigation  
 Municipal, Industrial, Other)

Description & Color of Materials Sand, Clay, Red Clay, Shell, etc.	Thick- ness Feet	Dep. Feet
RED CLAY		20
SANDY CLAY		40
BLUE CLAY		60
"		80
"		100
COARSE SAND		120

Information upon completion of well:

(1) Diameter: 2 inches.  
 (2) Total Depth: 118 feet.  
 (3) Water Level: 40 feet below top of ground.  
 (4) Cased to: \_\_\_\_\_, Size \_\_\_\_\_  
 (5) Screen: Size 2", Length 5'  
 (6) Were any formations sealed against pollution?  
 \_\_\_\_\_ yes, \_\_\_\_\_ no.

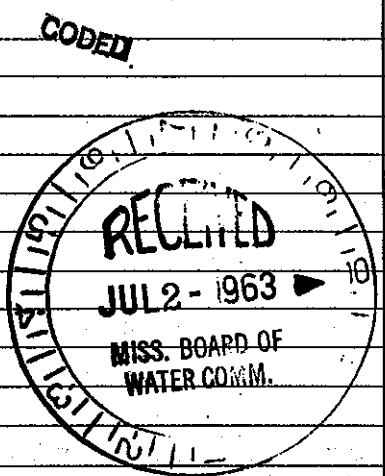

If YES depth of formation \_\_\_\_\_  
 Why \_\_\_\_\_  
 Drillers Remarks: \_\_\_\_\_

Well No.

(Use Back Side)