

Jeff Davis
MISSISSIPPI BOARD OF WATER COMMISSIONERS

H 9
6-23-65
CODED

WATER WELL DRILLERS LOG

CODED

Date: 6-23, 1965, Driller: S. S. Rouse County: Jefferson
(Name)


(1) Owner of Land:	Description & Color of Materials Sand, Clay, Red Clay, Shell, etc.	Thick- ness Feet	Depth Feet
<i>Pierres</i> Lester Rous (Name) Printer Miss (Address)	Red sand and gravel	100	
(2) Location: 1/4, 1/4, Sec. 1 T. 5 N. R. 19 12 miles South, of (distance) (direction) (Nearest Town)	Blue clay	190	
(3) Topography: <i>Hilly</i> (Hilly) (Flat) (Level)	Water sand	30	
(4) Purpose of Well: <i>Domestic</i> (Domestic Irrigation Municipal, Industrial, Other)			320

Information upon completion of well:

- (1) Diameter 4 inches.
- (2) Total Depth 320 feet.
- (3) Water Level 200 feet below top of ground.
- (4) Cased to 210, Size 4
- (5) Screens: Size 4, Length 10
- (6) Were any formations sealed against pollution?
yes, no.

If YES depth of formation _____
Why _____
Drillers Remarks: _____

CODED
CODED

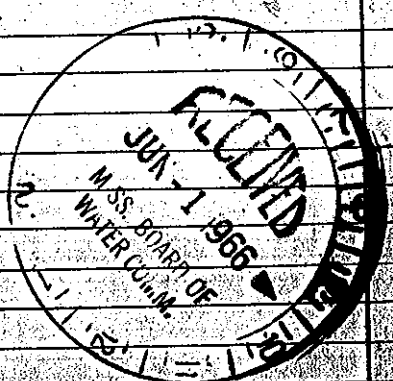

Well No.

(Use Back Side)