

County: Jeff Davis  
 Permit #: 0-586  
 Driller: JAMES WELLS  
 Date drilling completed: 7-26-12

**State Well Report**  
**Part 1 - Driller's Log**  
 Mississippi Department of Environmental Quality  
 Office of Land and Water Resources  
 P.O. Box 2309  
 Jackson, MS 39225  
 (601)961-5210  
 (601)961-5228 (fax)

For Office Use Only:  
 Aquifer: \_\_\_\_\_  
 Well #: H139  
 L. S. Elevation: \_\_\_\_\_  
 E-log #: \_\_\_\_\_

*State Law requires that this report be prepared by the license holder responsible for the work and filed with the Department at the above address within 30 days of completion of drilling of the well or borehole.*

<b>Information on Well Owner</b> (Landowner if borehole is not for a water well)		<b>Well or Borehole Location</b>	
Owner Name: <u>Donald Bryson</u>	Latitude: <u>31.28.43N</u>	Longitude: <u>89.57.8W</u>	
Mailing Address: <u>Joe Griffith Rd</u>	Method of Lat/Long (circle one): Conventional Survey, _____		
<u>Box 603 Oakvale, MS</u>	USGS quad, Hand-held GPS, Survey-grade GPS		
<u>39656</u>	SE 1/4 SW 1/4 Sec <u>18</u>	Twn <u>4N</u>	Rng <u>18W</u>
City _____ State _____ Zip Code _____	Distance <u>3</u> Miles	Direction <u>NW</u>	Nearest Town <u>Oakvale MS</u>
Telephone No. ( <u>504</u> ) <u>4606351</u>			

**Well / Borehole Data**

Date drilling started: 7-26-12 Date drilling completed: 7-26-12 Hole depth: 225 Hole diameter: 7

Location of the source of any surface water used for drilling: Creek Water

Method of dosing and volume of Chlorine used in drilling and development: Shuck 3 lb

Logs run (circle all applicable): No log run Electric Gamma Ray Density Sonic Neutron Other: \_\_\_\_\_

Name of organization running log(s): \_\_\_\_\_

Purpose of borehole (check one): Water Well  Geotechnical/Geological Investigation \_\_\_\_\_ Ground Source Heat Pump \_\_\_\_\_

Seismic Survey \_\_\_\_\_ Other (describe) \_\_\_\_\_

*If drilling is not related to water well construction, skip the remainder of this block*

Purpose of Well (check one): Home  Industrial \_\_\_\_\_ Public Supply \_\_\_\_\_ Irrigation \_\_\_\_\_ Fish Culture \_\_\_\_\_ Other: \_\_\_\_\_

If a flowing well, method of flow regulation: Valve \_\_\_\_\_ Other (describe) \_\_\_\_\_

Static Water Level: 140 feet above or below (circle one) land surface Date measured: 7-26-12

Method of Measurement (circle one) steel tape electric tape air line other: \_\_\_\_\_

Well depth: 225 Well grouted to a depth of \_\_\_\_\_ feet Type of grout (circle one): Neat Cement Bentonite Mix

Casing length: 205 feet Casing diameter: 4 inches Type of casing: PVC

Screen length: 20 feet Screen diameter: 4 inches Type of screen: PVC

Screen slot size: .008 inches Setting depth: From 205 feet to 225 feet

Type of completion (circle all applicable): Gravel packed Underreamed Telescoped Open hole Natural Development

Other (describe): \_\_\_\_\_

Top of lap pipe or reduction in casing: \_\_\_\_\_ feet. *If telescoped or more than one screen, describe on next page*


Form: OLWR-SWR-1A (04/08)

RECEIVED  
 SEP 10 2012  
 BY: OLWR

If well telescopes please sketch below and show depths.

H139

Ground Level

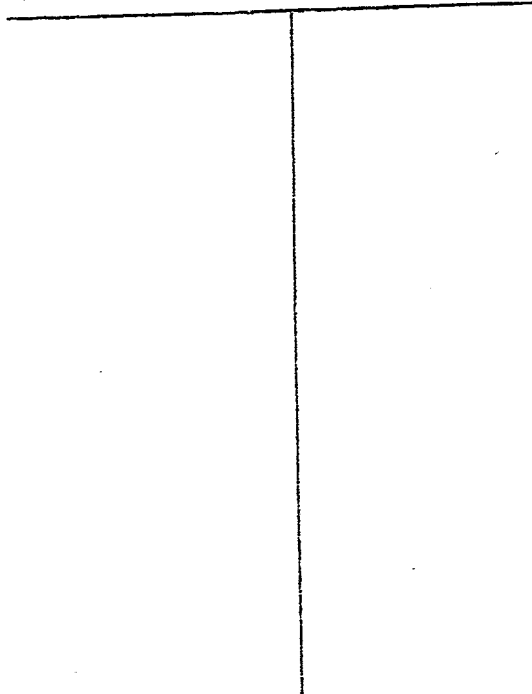

Description of Formations Encountered	From	To
Top Soil	0	2
Clay	2	40
Red sand	40	80
Gravel	80	160
Sand	160	225

If more than one screen, show location of each on sketch

Sketch the property layout and include the following: 1) the well location; 2) any permanent structures on the property that may aid in locating the well; 3) any roads, power lines, or other items that may aid in locating the property and the well; 4) indicate direction.

Landowner Name: Donald Bergner

James Wells  
Signature of Water Well Contractor

RECEIVED  
SEP 10 2012  
BY: OLWR

# STATE WELL REPORT

## Part 2

Pump Installer's Completion Report  
Mississippi Department of Environmental Quality  
Office of Land and Water Resources  
P.O. Box 10631  
Jackson, MS 39289-0631  
(601)961-5210  
(601)354-6938 (fax)

For Office Use Only:

Aquifer: \_\_\_\_\_

Well #: 4139

Elevation: \_\_\_\_\_

County: Jeff Davis  
Permit #: \_\_\_\_\_  
Driller: JAMES WELLS  
Date completed: 7-26-12

This report should be prepared by the pump installer in detail and filed with the Department within 30 days of the installation of pump.

Well Owner Information	Well Location
Owner Name: <u>Donald Brummett</u>	Latitude: <u>31-28-43N</u> Longitude: <u>89-57-8W</u>
Mailing Address: <u>Joe Griffith Rd</u> <u>Pox 603 Osedale MS</u> <u>39658</u>	Method of Lat/Long (circle one): <u>Conventional Survey</u>  USGS quad, Hand-held GPS, Survey-grade GPS
City: _____ State: _____ Zip Code: _____	<u>SE 1/4 SW 1/4 Sec 18 Twn 6N Rng 18W</u> <u>19W</u>
Telephone No. ( <u>504</u> ) <u>4606351</u>	Distance: <u>3</u> Miles Direction: <u>NW</u> of <u>Osedale MS</u>

Pump Type Circle one	Power Type Circle one
Air Lift: <input type="checkbox"/> Jet: <input checked="" type="checkbox"/> <u>Submersible</u>	Diesel Engine: <input type="checkbox"/> Gasoline Engine: <input type="checkbox"/> Natural Gas: <input type="checkbox"/>
Bucket: <input type="checkbox"/> Piston: <input type="checkbox"/> Turbine: <input type="checkbox"/>	<u>Electric Motor</u> : <input checked="" type="checkbox"/> Hand: <input type="checkbox"/> Tractor PTO: <input type="checkbox"/>
Centrifugal: <input type="checkbox"/> Rotary: <input type="checkbox"/> Flowing Well: <input type="checkbox"/>	Windmill: <input type="checkbox"/> Other (specify): _____
Other (specify): _____	Horse Power Rating of Motor: <u>1 1/2</u>
Date Pump Installed: <u>7-26-12</u>	Setting Depth: <u>200</u> feet
Rated Pump Capacity: <u>20</u> Gallons Per Minute	Number of Stages: <u>11</u>

Pump Test Data	Method of Measuring Water Level Circle one
Date Well Tested: <u>7-26-12</u>	Air Line: <input type="checkbox"/> Electric Measuring Line: <input type="checkbox"/> <u>Steel Tape</u>
Static Water Level (A): <u>140</u> Feet Below Land Surface	Other (specify): _____
Pumping Water Level (B): <u>200</u> Feet Below Land Surface	For flowing well, measured static head: _____ feet
Drawdown [(B) - (A)]: <u>160</u> Feet Below Land Surface	Well yielded <u>20</u> GPM with a drawdown of
Test Pumping Rate: <u>20</u> Gallons Per Minute	<u>140</u> feet after <u>4</u> hours of pumping
Duration of Pump Test (minimum 4 hours): <u>4</u> hours	

I HEREBY CERTIFY that the above statements are true to the best of my knowledge.

JAMES WELLS 0-586  
Print Name of Pump Installer and License No. (if applicable)

James Wells  
Signature of Pump Installer

RECEIVED  
SEP 10 2012  
BY: OLWR