

COMMISSIONERS

JEFF DAVIS

WATER WELL DRILLERS LOG CODED

Date: 2-6-63, 1963, Driller: E. B. SHERROD County Marion

(Name)

(1) Owner of Land: Lowell GARNED
(Name)
Bassfield, Miss.
(Address)

(2) Location: 1/4, 1/4, Sec. 27-6-18
5 miles S, W., of BASSFIELD
(distance) (direction) (Nearest Town)
MISS

(3) Topography: (Hilly) (Flat) (Level)

(4) Purpose of Well: Domestic
(Domestic Irrigation
Municipal, Industrial, Other)

Description & Color of Materials
Sand, Clay, Red Clay, Shell, etc.

Thick-
ness
Feet

Dept
Fee

RED SOFT CLAY
SANDY RED

20

40

60

80

100


120

140

CLAY & SAND
STREAKS
SAND & GRAVEL

CODED

CODED

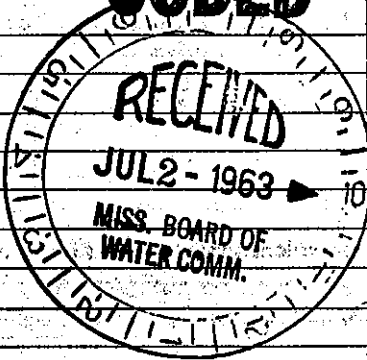

Information upon completion of well:

(1) Diameter 2 inches.

(2) Total Depth 125 feet.

(3) Water Level 100 feet below top of ground.

(4) Cased to _____, Size _____,

(5) Screen: Size 2", Length 5'

(6) Were any formations sealed against pollution?

_____ yes, _____ no.

If YES depth of formation _____

Why _____

Drillers Remarks: _____

Well No.

(Use Back Side)

Retain this copy for your office files.