

CODED

WATER WELL DRILLERS LOG

J 11
 F-25-63

Date: 1-25 1963, Driller: E. B. SHEPPARD county JEFFERSON
 (Name) DAVIS

(1) Owner of Land: Boyd Hatten
 (Name)
Bassfield, Miss.
 (Address)


(2) Location: 1/4, 1/4, Sec. 35 T8 R8
5 miles N. E. of BUNKER
 (distance) (direction) (Nearest Town)
HILL

(3) Topography: (Hilly) (Flat) (Level)

(4) Purpose of Well: Domestic
 (Domestic Irrigation
 Municipal, Industrial, Other)

Description & Color of Materials Sand, Clay, Red Clay, Shell, etc.	Thick- ness Feet	Depth Feet
<u>RED CLAY</u>		<u>20</u>
<u>SANDY CLAY</u>		<u>40</u>
<u>GRAY CLAY</u>		<u>60</u>
<u>PEA GRAVEL SAND</u>		<u>80</u>
		<u>00</u>

CODED

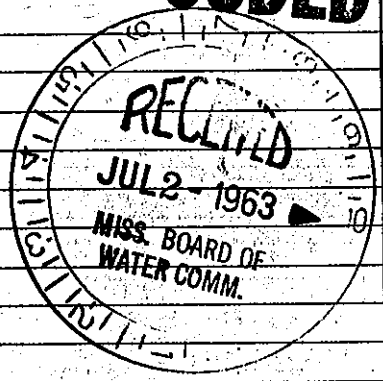

Information upon completion of well:

(1) Diameter 2 inches.

(2) Total Depth 92 feet.

(3) Water Level 40 feet below top of ground.

(4) Cased to _____, Size _____

(5) Screen: Size 2, Length 5'

(6) Were any formations sealed against pollution?
 _____ yes, no.

If YES depth of formation _____

Why _____

Drillers Remarks: _____

(Use Back Side)

WELL NO.