


JEFF. DAVES
 J 5.3
 2/10/81
 2-10-81
 date well completed

MISSISSIPPI DEPARTMENT OF NATURAL RESOURCES
 Bureau of Land and Water Resources
 Southport Mall
 P.O. Box 10631
 Jackson, Mississippi 39209
 WATER WELL DRILLERS LOG
 Griner Drilling Service, Inc.
 firm name

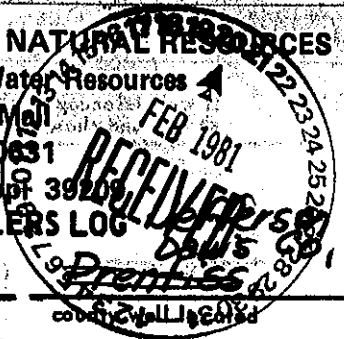

LANDOWNER:
 Forrest Oil Corporation
 P.O. Box 51225 O.C.S.
 Lafayette, La 70505
 (mailing address)

description of formations encountered	from	to
chalk	0	63
rock, chalk	63	168
streaked	168	210
pea gravel	210	378
chalk	378	399

WELL LOCATION: 1754' N + 2434' N
 No 1 sec. 16-T-6(N) R. 18 E of
 Bourdieu SE/4 of
 South of Prentiss
 (distance) (direction) (nearest town)

WELL PURPOSE: oil field supply
 (home, irrigation, municipal, industrial)

WELL COMPLETION DATA:
 (1) diameter (inches) 4"
 (2) total depth (feet) 399'
 (3) static water level (feet) 60' below top of ground.
 (4) casing Steel, 378' (material) (depth)
 4" (size) If telescope see back.
 (5) screen 42' 336' (length) (depth to top)
 4" perforated (size) (material)
 (6) pump (HP) 80 (yield gpm)
 AC (type power)
 (7) electric log (yes or no)
 (organization running log)
 (8) how well bottom plugged orange peel

DEPT. OF NATURAL RESOURCES
 BUREAU OF LAND & WATER RESOURCES
 FEB 20 1981

RECEIVED

DRILLERS REMARKS: