

Jeff Davis
 J55
 5-31-81

MISSISSIPPI DEPARTMENT OF NATURAL RESOURCES

Bureau of Land and Water Resources

Southport Mall

P.O. Box 10631

CODED

Jackson, Mississippi 39209

WATER WELL DRILLERS LOG

Griner Drilling Company, Inc. *Jefferson Davis*
 firm name county well located

5-31-81
 date well completed


LANDOWNER:	description of formations encountered	from	to
<i>Forrest Oil Corp.</i>			
<i>P.O. Box 51225 GCS</i>	<i>sand + gravel</i>	<i>0</i>	<i>77</i>
<i>Lafayette, La 70505</i> (mailing address)	<i>clay</i>	<i>77</i>	<i>224</i>
WELL LOCATION: <i>1500'S + 1144'W</i>	<i>sand</i>	<i>224</i>	<i>378</i>
<i>no. 20</i> <i>60</i> <i>R. 15</i> <i>of</i>	<i>clay</i>	<i>378</i>	<i>400</i>
<i>habits</i> <i>Vintage Field</i>			
(distance) (direction) (nearest town)			

WELL PURPOSE: *oil field supply*
 (home, irrigation, municipal industry)

WELL COMPLETION DATA:

- (1) diameter (inches) *4"*
- (2) total depth (feet) *400'*
- (3) static water level (feet) *90'* below top of ground.
- (4) casing *steel, 378'*
(material) (depth)
4" (size) If telescope see back.
- (5) screen *42'* *336'*
(length) (depth to top)
4" *perforated*
(size) (material)
- (6) pump *70*
(HP) (yield gpm)
ac
(type power)
- (7) electric log *_____*
(yes or no)
(organization running log)

1500'S + 1144'W of NE 1/4 of Sec.

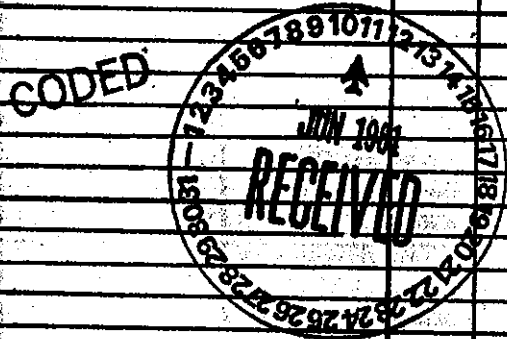

(8) how well bottom plugged *orange pell*

DRILLERS REMARKS: