	<b>STATE</b>	WELL REPORT	
county: Jefferson Davis		Part 1	For Office Use Only:
Permit #:	D	viller's Log	Wall # 195
Driller: James M. Wells	Mississippi Depart Office of La	ment of Environmental Quality and and Water Resources	Aquifer:
Date drilling completed: 10-17-18	F	P.O. Box 2309	E-Log #:
		on, MS 39225-2309 601)961-5210	
	(60	1)360-0535 (fax)	
State Law requires that this report I Department at the above address wi	unin 50 days of con	license holder responsible for npletion of drilling of the well	the work and filed with the or borehole.
Well Owner Information	on	Well or Bor	ehole Location
(Landowner if borehole is not for a water well) Owner Name: Ashley Reid		Latitude: 31-35.50NLc	89-50 10.22
Mailing Address:		Method of Lat/Long (check on	e): Conventional Survey,
36 Reid Lane			GPS, Survey-grade GPS
City State	39427 Zip Code	<u>SE 14 SW 14, Sec</u>	32 TON RISW
Telephone No. ()	-	MilesOistance) (Direction)	of(Nearest Town)
	Electric Gamma Velt Geotechnica Survey Other (d ed to water well cor	a Ray Density Sonic Neutro	Ground Source Halffump
Purpose of Well (circle all applicable):	<u>_</u>		Fish Culture
f a flowing well, method of flow regulati			
Static Water Level: <u>25</u> feet [a	above or below] ( (circle one)	and surface Date measured	10-17-18
Method of measurement (circle one) Stee	el tabe Electric tar	De Airline Other (describe):	
Vell depth: Well grouted to a de	epth of: <u>//</u> fee	t Type of grout (circle one):	Neat Cement Bentonito His
asing length:feet Casir	ng diameter:	inches Type of c	$\Omega$
creen length: <u>20</u> feet Scre	een diameter:	<u>Sinches</u> Type of s	
creen slot size: .008inches	Setting depth: F	romfeet to	feet
ype of completion (circle all applicable)	Gravel packed	Underreamed Open hole	Natural Development
ther (describe):			
op of lap pipe or reduction in casing:			
		screen, describe on next page	e

R E


County:	Jefferson,	Davis	
---------	------------	-------	--

Permit #:

For Office Use Only: Well #: <u>J95</u>

The sketch below only required for water wells

If well telescopes, show depths on sketch.

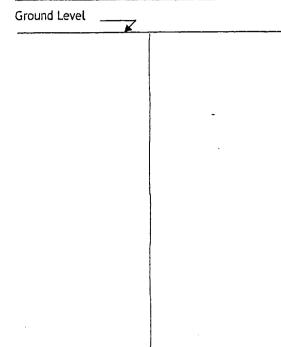

Description of formations encountered must be provided for all wells and boreholes, unless specifically exempted by regulations

Description of Formations Encountered	From (depth) Ground level	To (depth)
	Ground level	
topsor Elay Sand		
Sand		
	1	
	1	
· · · · · · · · · · · · · · · · · · ·		
		·

If more than one screen, show location of each on sketch

Sketch the property layout and include the following: 1) the well location

2) any permanent structures on the property that may aid in locating the well

3) any roads, power lines, or other items that may aid in locating the property and the well

4) north arrow

xwell

HSDIE Landowner Name:

I HEREBY CERTIFY that the well/borehole was drilled, constructed, and completed in accordance with all applicable requirements of the Mississippi Department of Environmental Quality and the Mississippi Department of Health regulations, if applicable, and state laws.

51)-18 00005889 James In ang Signature of Licensee Print Name of Responsible Licensee and License No Date

Form: OLWR-SWR-1A (4/13)

RECEIVED DEC D 6 2018 BY OLWR

STATE W	ELL REPORT			
County: DRFERSON Davis	Part 2	For Office Use Only:		
Permit #: Pump Installe	er's Completion Report	Well #:		
Driller: Dames III. Wells Office of La	nent of Environmental Quality nd and Water Resources	well #:		
Data completed 1/2-12-18	2.O. Box 2309 n, MS 39225-2309	Aquifer:		
Copy information from block on Part 1	601)961-5210 ) 360-0535 (fax)			
This part of the report must be completed by a licensed water of the report must be attached and both parts filed with the L	r well contractor or a licensed pur Department at the above address w	np installer. A copy of Part 1 ithin 30 days of well completion.		
Well Owner Information		ocation		
Owner Name: Ashley Reid	Latitude: 31° 25.50 Lor	gitude: 89 56,31W		
Mailing Address:	31-26-11.87 Method of Lat/Long (check one	Stand Science and a standard science and s		
36 Reid Lane		PS, Survey-grade GPS		
Carson MS 39427		32 TEN RISW		
City State Zip Code	Miles of (Direction)	(Nearest Town)		
	pe (circle one)			
Submersible Turbine Air Lift Centrifugal Flowing Well				
Date Pump Installed:		Gallons Per Minute		
Is This Pump (circle one): (New) Repaired Replaceme				
	rpe (circle one)			
Electric Diesel Gasoline Natural Gas Tractor PTO Wir				
Horse Power Rating of Motor: Setting Dept	th: <u>30</u> feet Number	of Stages:		
Pump Test Data Date Well Tested: <u>10-17-18</u> Static Water Level (A): <u>25</u> Feet Below Land Surface	for Non Flowing Well	FICEIVEL		
Date Well Tested:	Duration of Pump Test (minim	num 4 hours): Rt hourson 8		
Date Well Tested: $1077-78$ Static Water Level (A): $25$ Feet Below Land Surface Drawdown ((B) = (A)1: 32 Feet Below Land Surface	Pumping Water Level (B): 🛓	50 Feet Below DEAL Surface		
	face Test Pumping Rate:	Gallons Per Milter		
Method of measurement (circle one); Steel tapy Electric to	ane Airline Other (describe):	BYUT		
	ata for Flowing Well			
Measured shut in head:feet.	-			
Well yieldedGPM with a drawdown of	feet after	hours of pumping		
	Installation			
Meter Manufacturer: Meter Serial Number:				
Meter Model Number/Name: Type of Meter:				
Totalizer Register Unit and Multiplier Factor (AF x .001, ga	l x 1000, etc):			
Installation Date: Meter installed by:				
Is This Meter (circle one): New Repaired Replacem	ent			
Important: By submitting the above information you are c For agricultural wells, a list of ap	ertifying that this meter was insta proved meters is on the MDEQ w	lled to manufacturer standards. ebsite.		
I HEREBY CERTIFY that the above statements are true to the	ne best of my knowledge.			
	4	11		
Tames M. Wells 00005789 Print Name of Pump Installer and License No. (if applicable	e) Date Signa	ture of Rump Installer		

4 1