

MISSISSIPPI BOARD OF WATER COMMISSIONERS

Jeff DAVIS

L2 CODED
3-18-62

WATER WELL DRILLERS LOG CODED

Date: 5/18/62, 19__ Driller: Jay Galt County: Jeff Davis
Hatterhio Barlowe Gacs

(1) Owner of Land: Buck Jernsd
(Name)

Route 1, Sumrall, Miss
(Address)

(2) Location: 1/4, 1/4, Sec. 18 T6R16

miles. of
(distance) (direction) (Nearest Town)

(3) Topography:
(Hilly) (Flat) (Level)

(4) Purpose of Well:
(Domestic Irrigation, Municipal, Industrial, Other)

Description & Color of Materials Sand, Clay, Red Clay, Shell, etc.	Thick- ness Feet	Depth Feet
red clay	0	20
white clay	20	90
white sand	90	116

Information upon completion of well:

(1) Diameter _____ inches.

(2) Total Depth 116 feet.

(3) Water Level 52' feet below top of ground.

(4) Cased to 2", Size 2"

(5) Screen: Size 2", Length 10'


(6) Were any formations sealed against pollution?
_____ yes, _____ no.

If YES depth of formation _____

Why _____

Drillers Remarks: _____

CODED

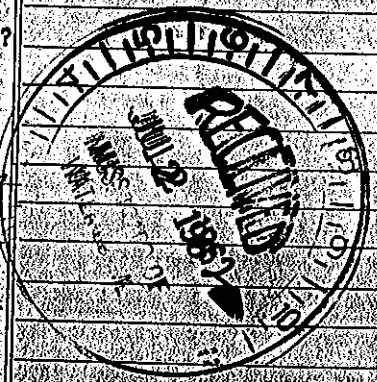

Well No

(Use Back Side)

Retain this copy for your office files.