

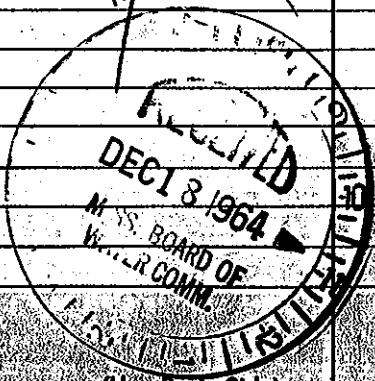
JEFFERSON MISSISSIPPI BOARD OF WATER COMMISSIONERS

D 16
10-4-64

WATER WELL DRILLERS LOG

CODED

Date: Oct. 4, 1964, Driller: Robert E. Raloff County: Jefferson
(Name)

(1) Owner of Land:	Description & Color of Materials Sand, Clay, Red Clay, Shell, etc.	Thick- ness Feet	Depth Feet
<u>Lorman Water Ass.</u> (Name)	<u>Red clay & sand</u>	<u>0</u>	<u>23</u>
<u>Lorman, Miss</u> (Address)	<u>sand</u>	<u>23</u>	<u>38</u>
(2) Location: <u>46 10N 2E</u> _____ 1/4, _____ 1/4, Sec. _____ T. _____ R. _____	<u>white clay</u>	<u>38</u>	<u>46</u>
_____ miles _____ of <u>Lorman</u> (distance) (direction) (Nearest Town)	<u>white clay</u>	<u>46</u>	<u>69</u>
(3) Topography: <u>Hilly</u> (Hilly) (Flat) (Level)	<u>Blue clay</u>	<u>69</u>	<u>91</u>
(4) Purpose of Well: <u>Municipal</u> (Domestic Irrigation Municipal, Industrial, Other)	<u>Blue clay</u>	<u>91</u>	<u>114</u>
Information upon completion of well:	<u>Clay & sand streaks</u>	<u>114</u>	<u>160</u>
(1) Diameter: <u>8x6</u> inches.	<u>sand + shale streaks</u>	<u>160</u>	<u>183</u>
(2) Total Depth: <u>279</u> feet.	<u>shale rocks</u>	<u>183</u>	<u>190</u>
(3) Water Level: <u>170</u> feet below top of ground.	<u>sand fine</u>	<u>190</u>	<u>205</u>
(4) Cased to: <u>279</u> , Size <u>8x6</u>	<u>sand</u>	<u>205</u>	<u>228</u>
(5) Screen: Size <u>6"</u> , Length <u>10'</u>	<u>sand</u>	<u>228</u>	<u>250</u>
(6) Were any formations sealed against pollution? <input checked="" type="checkbox"/> yes, _____ no.	<u>Course sand</u>	<u>250</u>	<u>272</u>
If YES depth of formation: <u>omitted</u>	<u>Course sand</u>	<u>272</u>	<u>279</u>
Why _____	<p style="text-align: center;">CODED</p> <p style="text-align: center;">Location ↓ N 1/4 - 69</p> 		
Drillers Remarks: _____			

Mail this copy to Board of Water Commissioners 429 Miss. St. Jackson, Miss.