

MISSISSIPPI DEPARTMENT OF NATURAL RESOURCES

Bureau of Land and Water Resources

Southport Mall

P.O. Box 10631

CODED

Jackson, Mississippi 39209

WATER WELL DRILLERS LOG

Jefferson
F 8
6-25-81

6-25-81 date well completed 1981
Rabjohn Drill & Const. Co. firm name
Jefferson county well located


LANDOWNER:	description of formations encountered:	from	to
B. H. Fortenkerry	Top Soil	0	2
Yatchey, Ms. (mailing address)	clay	2	153
WELL LOCATION:	sand	153	320
sec. 25 T 9 S R 2 E	grey clay	320	305
5 miles NW of Church Hill	sand	305	335
(distance) (direction) (nearest town)			

WELL PURPOSE:
(home, irrigation, municipal, industrial)

WELL COMPLETION DATA:

- (1) diameter (inches) 3"
- (2) total depth (feet) 335'
- (3) static water level (feet) 180' below top of ground
- (4) casing (material) BWC (depth) 315'
- (size) 3" If telescope see back.
- (5) screen (length) 80' (depth to top) 315'
- (size) 3" (material) slotted pipe
- (6) pump (HP) (yield gpm) 50 GPM
- (type power)
- (7) electric log (yes or no) NO
- (organization running log)
- (8) how well bottom plugged Wood Plug

for most W 1/4 cor of Sec. 25
go SE 1/4 along between
Sec. 24 + 25 for 2000'
to NE 1/4 of R 2 E T 9 S
in Sec. 25 NW 2 W.

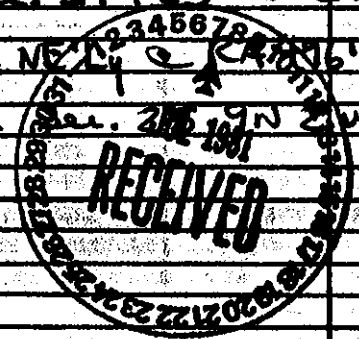

CODED

DRILLERS REMARKS: