State V	Vell Report
Jefferson 1	Part 1
Mississippi Departme	nt of Environmental Quality Aquifer:
	Box 10631
Driller: <u>Gary Navporn</u> Jackson, J	MS 39289-0631 L. S. Elevation:
)961-5210 54-6938 (fax) E-log #:
State Law requires that this report be prepared by th 30 days of completion of drilling of the well.	e driller in detail and filed with the Department within
Well Owner Information	Well Location
Owner Name_Ben Rushing	Latitude:' Longitude:'
Mailing Address: 1715 Hurricone Lake RdSu	Method of Lat/Long (circle one): Conventional Survey,
_	USGS quad; Hand-held GPS, Survey-grade GPS
Brookhaven MS 39601	<u>14 14 Sec 12 Twn 9N Rng 1W</u>
City State Zip Code	Distance Direction Nearest Town
Telephone No. (601) 757 - 8319	Distance Direction Nearest Town Miles <u>N-NW</u> of <u>Church</u>
	l Data
Purpose of Well (circle one) Home Industrial Public Supply	Irrigation Fish Culture Other:
Purpose of Well (circle one) Home mutualitation industrial	8/21/07
Date well drilling started: 82107 Dat	
If flowing, method of flow regulation: Valve Other	(describe)
Static Water Level: <u>30'</u> feet above or below circle one	
Method of Measurement (circle one) steel tape electric ta	
Hole depth: 120' Well depth: 120'	Well grouted to a depth offeet
Type of grout (circle one): Cement Bentonite M	2.1
Casing length: <u>100</u> feet Casing diameter: <u>4</u>	Inches Type of cashig:
Scient inigin	inches Type of screen:
Screen slot size: <u>. 010</u> inches Setting depth: From	
Type of completion (circle all applicable): Gravel packed Un	derreamed Telescoped Open hole Natural Development
	f telescoped or more than one screen, describe on back of page
Logs run (circle all applicable) No log run Electric Gamma F	ay Density Sonic Neutron Other:
Name of organization running log(s):	
I certify that the well was drilled, constructed, and completed	in accordance with all applicable requirements of the Mississippi
Department of Environmental Quality and/or the Mississippi	Jeparunent of meatur regulations and state laws.
RAYBORN DRILLING, INC. 0-60	de la
Print Name of Water Well Contractor and License No.	Signature of Water Well Contractor


If well telescopes please sketch below and show depths.



Description of Formations Encountered	From	To
 СНАЦК	0	85
COARSE SAND	85	120
		+

6-26

If more than one screen, show location of each on sketch

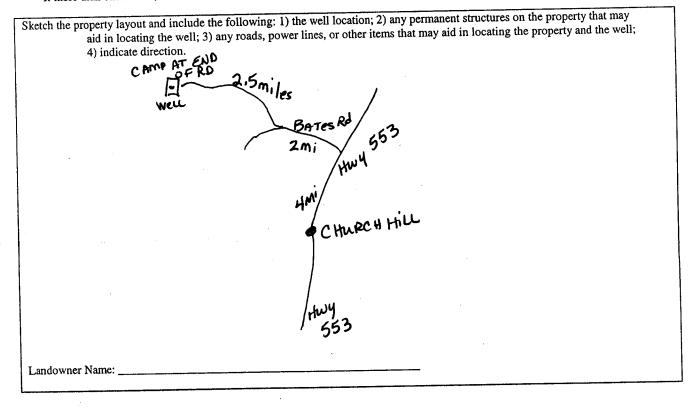

Signature of Water Well Contractor

			LL REPORT		
County: Jeffers			Completion Report	For Office Use Only:	
•		Mississippi Department	Aquifer:		
ermit #:	<u> </u>	Office of Land and Water Resources P.O. Box 10631		-0.21	
Permit #: Driller: <u>Gary Ro</u>	in pow	P.O. Box 10631 Jackson, MS 39289-0631		Well #: 6-26	
Date completed: 821	107		961-5210	Elevation:	
			I-6938 (fax)		
installation of pump.			and filed with the Departme		
Well Owner Information			Well Location		
Owner Name: Ben Rushing			Latitude: Longitude:		
Mailing Address: 1715 Hurricane Lake Rd SW		Method of Lat/Long (circle one): Conventional Survey,			
			USGS quad, Han	d-held GPS, Survey-grade GPS	
Brookhaven MS 3960/ City State Zip Code		1/41/4 Sec/	2		
City	State	Zip Code	Distance Direction	Nearest Town	
Telephone No. (60)	757 - 8	379	8 Miles N-NW	of Church Hill	
				ower Type	
	Pump Type Circle one			Circle one	
Air Lift	Jet	Submersible	Diesel Engine Gasol	ine Engine Natural Gas	
Bucket	Piston	Turbine C	Electric Motor Hand	Tractor PTO	
Centrifugal	Rotary	Flowing Well		r (specify):	
Other (specify):			Horse Power Rating of Moto	ог. <u>I НР</u>	
Date Pump Installed:		2007	Setting Depth:	60feet	
Rated Pump Capacity:			Number of Stages:		
	Pump Test Dat			leasuring Water Level	
Date Well Tested:	8 21 20	700		Circle one	
Static Water Level (A):				easuring Line Steel Tape	
Pumping Water Level (B)			Other (specify):		
Drawdown [(B) – (A)]:			For flowing well, measured	shut in head:feet	
Test Pumping Rate:			Well yielded10	GPM with a drawdown of	
Duration of Pump Test (*	feet after	hours of pumpin	
			-fun Imanilados		
HEREBY CERTIFY &	•	tements are true to the best $0 - 60$	of my knowledge.		

.4