

**JEFFERSON MISSISSIPPI BOARD OF WATER COMMISSIONERS**

**6 2000 WATER WELL DRILLERS LOG**  
**9-22-60**


Date: 9/22, 1960, Driller: G River Water Well Saw County Jefferson  
 (Name)

(1) Owner of Land:	Description & Color of Materials Sand, Clay, Red Clay, Shell, etc.	Thick- ness Feet	Depth Feet
<u>Charles Lehman</u> (Name) <u>Fayette, Miss.</u> (Address)	<u>TOP SOIL</u>	<u>0 to 4</u>	
(2) Location: <u>1/4</u> , <u>1/4</u> , Sec. <u>T 9 R 1 W</u> <u>15</u> miles <u>West</u> , of <u>Fayette</u> (distance) (direction) (Nearest Town)	<u>GRAY CLAY</u>	<u>4 - 70</u>	
(3) Topography: <u>FLAT</u> (Hilly) (Flat) (Level)	<u>RED SAND</u>	<u>70 - 82</u>	
(4) Purpose of Well: <u>Live Stock</u> (Domestic Irrigation Municipal, Industrial, Other)	<u>SAND</u>	<u>82 - 115</u>	

**Information upon completion of well:**

- (1) Diameter 4 inches.
- (2) Total Depth 115 feet.
- (3) Water Level 20 feet below top of ground.
- (4) Cased to 105, Size 4"
- (5) Screen: Size 4", Length 10 FT
- (6) Were any formations sealed against pollution?  
 yes,  no.

If YES depth of formation \_\_\_\_\_  
 Why \_\_\_\_\_  
 Drillers Remarks: \_\_\_\_\_

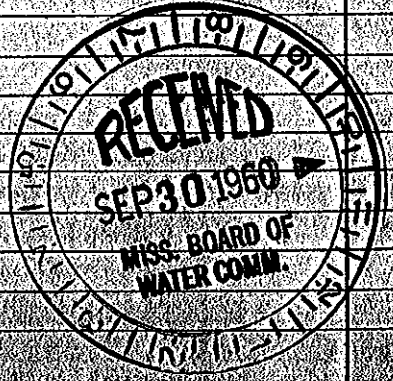

(Use Back Side)

Well No.