

MISSISSIPPI DEPARTMENT OF NATURAL RESOURCES
Bureau of Land and Water Resources

P.O. Box 10631
Jackson, Mississippi 39209
WATER WELL DRILLERS LOG

COUNTY WELL LOCATED <i>Jefferson</i>	
WELL NUMBER <i>2033</i>	CODED
PERMIT NUMBER	
NAME OF DRILLING FIRM <i>Green Water Well & Supply Inc.</i>	
DATE WELL COMPLETED <i>10-20-88</i>	

NAME & MAILING ADDRESS OF LANDOWNER <i>Scott Sandoz</i>		
<i>2003 S. State St.</i>		
<i>Abbeville, La</i>		
WELL LOCATION: SEC	TOWNSHIP	RANGE
<i>5</i>	<i>9</i>	<i>(N) S 1 (W)</i>
DISTANCE <i>15</i> Miles	DIRECTION <i>NW</i>	NEAREST TOWN <i>Fayette</i>
OTHER LANDMARK <i>Lake Rodney Camp</i>		
WELL PURPOSE: Home, Irrigation, Municipal, Industrial, Fish Pond, etc. <i>Camp</i>		

PUMP DATA		
PUMP TYPE (Circle One): <input checked="" type="radio"/> Submersible Turbine Jet Flowing Well, Other (Describe) _____		
POWER TYPE (Circle One): <input checked="" type="radio"/> Electric Tractor Diesel Gasoline Butane, Other (Describe) _____ H/P <i>1/2</i>		
Pump Capacity (GPM) <i>10</i>	No. of Stages <i>10</i>	Setting Depth <i>65</i> FT.
PUMP TEST		
Well yielded <i>14</i> GPM with a drawdown of <i>0</i> ft. after <i>2</i> hours of pumping		


WELL DATA		
Well Depth <i>113</i>	Casing Diameter (in.) <i>4</i>	Casing Length (ft.) <i>103</i>
Type of Casing <i>PVC</i>	Hole Depth <i>120</i>	Depth to Static Water Level <i>35</i>
TYPE OF COMPLETION: (Circle One or More): <input checked="" type="checkbox"/> Gravel Packed <input type="checkbox"/> Underreamed <input type="checkbox"/> Telescoped, <input type="checkbox"/> Natural Development <input type="checkbox"/> Open Hole <input type="checkbox"/> Other (Describe) _____		
Top of Lap Pipe or Reduction in Casing FEET IF TELESCOPED OR MORE THAN ONE SCREEN: USE BACK PAGE		

LOG DATA	
TYPE OF LOG RUN (Circle One): <input checked="" type="radio"/> No Log Run, Electric, Gamma Ray, Density, Sonic, Neutron, Other (Describe) _____	
Name of Organization Running Log	

SCREEN DATA		
Diameter - Inches <i>4</i>	Length - Feet <i>10</i>	Slot Size - Inches <i>.010</i>
Screen Type <i>PVC</i>	Depth to Bottom - Feet <i>113</i>	

GEOLOGIC DATA (Office Use Only)			
Surface Elev.	Geologic Unit	Unit Thickness	Depth to Top
Subs. SWL	Date	Analysis	Aquifer Test
Driller's Remarks			

DESCRIPTION OF FORMATIONS ENCOUNTERED	FROM	TO	FROM	TO
<i>Blue Clay</i>	<i>0</i>	<i>40</i>		
<i>Sand</i>	<i>40</i>	<i>113</i>		

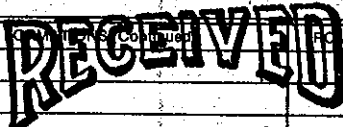

FEB 15 1989

Department of Natural Resources
Bureau of Land & Water Resources

IF MORE SPACE IS NEEDED, USE BACK